


KANSAS

Map No. _____ Sec. 1 Twp. 20 R. 90Well No. 1 Markell Farm
Langston et al Company

NORTH

WEST

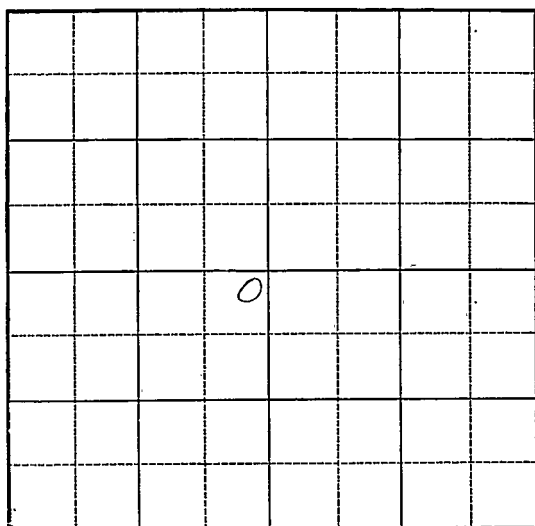

EAST

SOUTH

Location _____
Drilling Remarks _____Rig Up _____
Drilling Remarks _____

RECORD

Cased _____ in. _____ ft.

Sand _____

Gas _____

Oil _____

Total Depth _____

PRODUCTION

1st 24 hrs. Nat. _____

1st 24 hrs. after shot _____

Gas _____ cu. ft.

Dry Hole _____

Abandoned _____

Rice

Map No. KANSAS Sec. 1 Twp 20^S R. 9^W

Well No. #1 Markle Farm


Langston et al Company

165 Ft. from N. Line

 Ft. from S. Line

165 Ft. from E. Line

 Ft. from W. Line

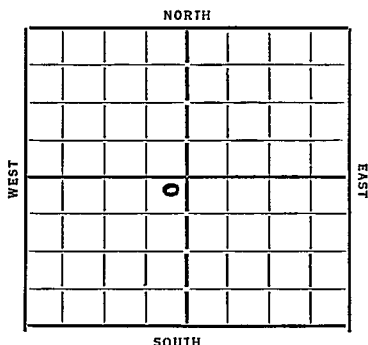

Date	REPORT
1933	
10/18	Location
10/25	Bldg
11/1	Rig 11/8 — 11/15 —
11/22	— 20" at 77
11/29	Drilg 200 15" - 150
12/6	— 12/12-990' a.D.
12/27	— 1/11 — 1/17 — 1/24 —
1/31	— 2/7 — 2/14 — 2/23 —
3/1	— 3/8 — 3/15 — 3/22 —
3/29	CO 990
4/5	7sg 1105
4/12	Drilg 1170 12" 1111
4/19	S.D. 1185
4/26	— 5/3 — 5/10 —
5/18	—
5/25	W. R. 12" 1194
5/31	Drilg 1270
6/7	" 1720
6/14	" 2141 10" 1739 S.D. 1970-85
6/21	7sg 2425
6/28	— 7/5 — 7/12 —
	- over -

7/19 Run 8"

7/26 — 8/2 —

8/9 5D

8/16 — 8/23 — 8/30 —

9/6 dly 2727 8" 2440

9/13 2750 u.r. 8"

9/20 2750 dly.

9/27 5D 2870

10/4 6" 2868 sho gas 2883-85

10/11 — 10/18 — 10/25 — 11/1 —

11/8 J.S.O. 2890 T? 2906 5D

11/15 — 11/22 — 11/28 — 12/6 —

12/13 — 12/21 — 12/27 — 1/3/35 —

1/10 — 1/17 —

1/24 5D 2966

1/31 dly 2989

2/7 5D 3003

2/14 —

2/21 dly 3114 3070 HFW

2/28 3082 u.r. pipe

3/7 dly 3082 6" 3040

3/14 Cong 3235 dly 3266

3/20 Siliceous 3415 T? 3420
D.T. F.

ABANDONED

Map No. 49 Sec. 1 Twp. 20 R. 9W

Well No. 1-Markle

Langston et al Company

Contractor

SECTION PLAT

165 Ft. from N. Line

Ft. from S. Line

165 Ft. from E. Line

Ft. from W. Line

FIRST REPORTS

	0		

Location ✓

Rig up

Drilling and Remarks:

RECORD

Cased in., ft.

Sand

Gas

Oil

Total Depth

PRODUCTION

1st 24 hrs. Nat.

1st 24 hrs. after shot

Gas Cu. Ft.

Dry Hole

Abandoned

Date

10-18-33 192 O. W. Wamschreck Scout

Map No. 49 Sec. 1 Twp 20 R. 9WWell No. 1-MarkleLangston et al Company

Contractor

ABANDONED

SECTION PLAT

165 Ft. from N. Line

Ft. from S. Line

165 Ft. from E. Line

Ft. from W. Line

	0		
	1		

Location

Rig up

Drilling and Remarks:

NO + A

RECORD

Cased in., ft.

Sand siliceous 3415

Gas

Oil

Total Depth 3420

PRODUCTION

1st 24 hrs. Nat.

1st 24 hrs. after shot

Gas Cu. Ft.

Dry Hole

Abandoned

Date

3-20-35

192

ORVAL MANNECHRECK

Scout