

KANSAS

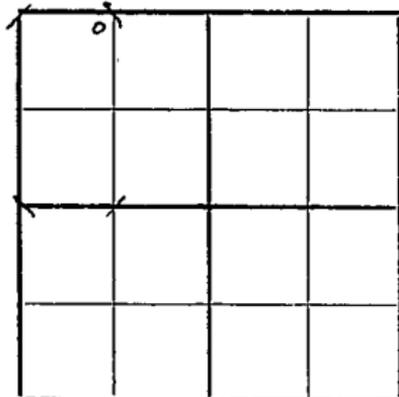
Rice

Map No. 48 Sec. 1 Twp. 20 R. 6WWell No. 1 BradenWestgate-Greenland et al. Company**FIRST REPORT**

Contractor

NE NW NW

SECTION PLAT

330 Ft. from N. Line

_____ Ft. from S. Line

_____ Ft. from E. Line

990 Ft. from W. Line

SMYERS POOL

Location XX

Rig up _____

Drilling and Remarks:

RECORD

Cased _____ in., _____ ft.

Sand _____

Gas _____

Oil _____

Total Depth _____

PRODUCTION

1st 24 hrs. Nat. _____

1st 24 hrs. after shot _____

Gas _____ Cu. Ft.

Dry Hole _____

Abandoned _____

Date

APR 8 1942 19

S. J. LEWIS

Scout

Rice

KANSAS

Map No. 48 Sec. 1 Twp. 20 R. 6WWell No. 1 BradenWestgate-Greenland et al Company**ABANDONED**

Contractor

NE NW NW

SECTION PLAT

330 Ft. from N. Line

0			

_____ Ft. from S. Line

_____ Ft. from E. Line

990 Ft. from W. Line

SMYRES POOL

Location _____

RECORD

Cased _____ in., _____ ft.

Rig up _____

Sand _____

Drilling and Remarks:

Gas _____

Miss 3324

Oil _____

*7" @ 3328.*Total Depth 3384*No Ted.*

PRODUCTION

1st 24 hrs. Nat. _____

1st 24 hrs. after shot _____

Gas _____ Cu. Ft.

Dry Hole _____

Abandoned _____

Date

MAY 6 1942 19S. J. LEWIS Scout