

Section 1 Township 20 Range 6 W

Well No. # 2 Braden "C"

Company Braden Oil Co.


Rice

KANSAS

Sec. 1 Twp. 20 R. 6 W /

Well No. # 2 Braden (C) Farm

Braden Oil Co. Company

Contractor


Ft. from N. Line

990 Ft. from S. Line

Ft. from E. Line

330 Ft. from W. Line

NW SW SE

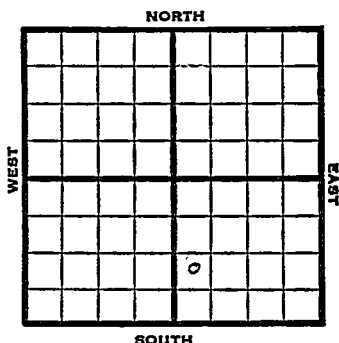

1951

Elev. 1552' REPORT


7/3

Spud 6-28-51  
8" @ 143  
Drlg. 2100'

8/8

Spud 6-28-51  
Oil well TD 3328'  
8" @ 143' Miss 3309-10'  
5" @ 3309' TD 3328' FU 2500'  
oil 3 hr. S/108 BO 3 hr.  
Comp. 240 BOPD

COMPLETED

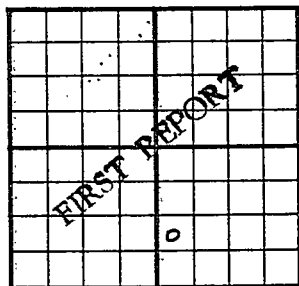County Rice State KansasSec. 1 (Blk.) 20 (Sur.) 6W Map No.Operator Braden Oil Co.Well No. 2 Farm Braden (C)Elev. Location NW SW SE990 Ft. From S Line SE330 Ft. From N Line Quarter1st. Report JUL 3 1951

Completion

Remarks


Spudding Date 6-28-51

Drlg. Data

8" @ 143 Drgl. 2100'

J. E. LYRA

County Rice State Kansas  
 Sec. 1 (Blk.  
Twp.) 20 (Sur.  
Rge.) 6W Map No.  
 Operator Braden Drlg.  
 Well No. 2 Farm Braden "C"  
 Elev. 1552 Location NW SW SE

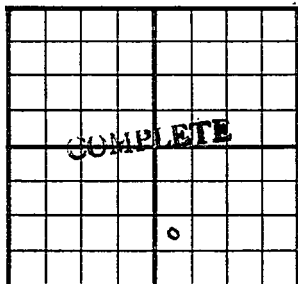

990 Ft. From S Line SE  
330 Ft. From W Line Quarter

1st. Report

Completion AUG. 8 1951

Remarks

Spudding Date 6-28-51

Drlg. Data Oil well TD 3328  
8" @ 143 Miss. 3309-10 5" @ 3309  
TD 3328 FU 2500' oil 3 hr. S/ 108 bo  
3 hr. Comp. 240 bopd

J. E. TYRA