

Rice

FORM 51 5M 6-46 PETROL

KANSAS

Section 1 Township 20 Range 6W

Well No. 1 Fee

Company J. W. Braden

		Wherry				NORTH	
				0			
						SOUTH	

WEST EAST

KANSAS

Rice County

Sec. 1 Twp. 20 R. 6W

Well No. 1 Fee Farm

J. W. Braden Company

Wherry Pool

330


Ft. from N. Line

Ft. from S. Line

Ft. from E. Line

330

Ft. from W. Line

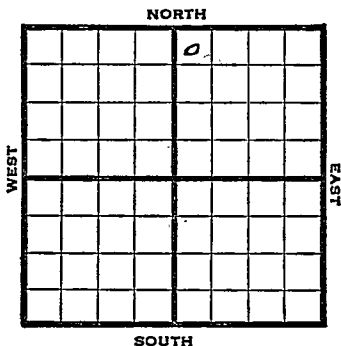

NW NE

1947

Elev. 1587'

REPORT

5/7 RUR
5/13 8" @ 161'
Dr1g 2300'
5/20 Dr1g 3295'
5/27 Miss 3357
TD 3362'
5" @ 3360'
RUST


6/3 " "
6/10 1800' oil
6/17 Swb. 50 bbls. oil 24 hrs.
6/24 " "
7/2 Miss. 3357'
5" @ 3360'
Pump 50 Pot
39.0 Gr.
TD 3362'

COMPLETED

Map No. K48 Sec. 1 Twp. 20 R. 6WWell No. 1 FeeJ. W. Braden CompanyFIRST REPORT Contractor

NW NE

SECTION PLAT

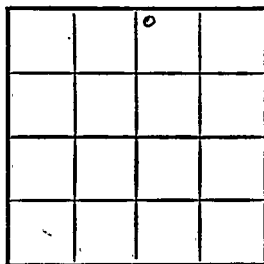330 Ft. from N. Line Ft. from S. Line Ft. from E. Line330 Ft. from W. Line

Rice County

Location

Rig up

Drilling and Remarks:

R U R

RECORD

Cased in., ft.Sand Gas Oil Total Depth 2350

PRODUCTION

1st 24 hrs. Nat. 210671st 24 hrs. after shot 21067Gas Cu. Ft.Dry Hole Abandoned 2350

Date

MAY 7 1947 19

S. J. LEWIS Scout

Map No. 48 Sec. 1 Twp. 20 R. 6W

Well No. 1 Fee

J. W. Braden Company

COMPLETE

Contractor

NW NE

E1187
SECTION PLAT

330 Ft. from N. Line

_____ Ft. from S. Line

_____ Ft. from E. Line

330 Ft. from W. Line

		6	

Rice County

Location _____

Rig up _____

Drilling and Remarks:

Miss 3357

5" C 3360

Run 50 ft.

89 2/4

RECORD

Cased _____ in., _____ ft.

Sand _____

Gas _____

Oil _____

Total Depth 2362

PRODUCTION

1st 24 hrs. Nat. _____

1st 24 hrs. after shot _____

Gas _____ Cu. Ft.

Dry Hole _____

Abandoned _____

Date

JUL 2 1947 19

S. J. LEWIS Scout