


McPherson

Form 51—5M—11-31—Palace

Map No. **KANSAS** Sec. *1* Twp. *20* R. *2 W*

Well No. *2 Flook* Farm
Jones et al Company

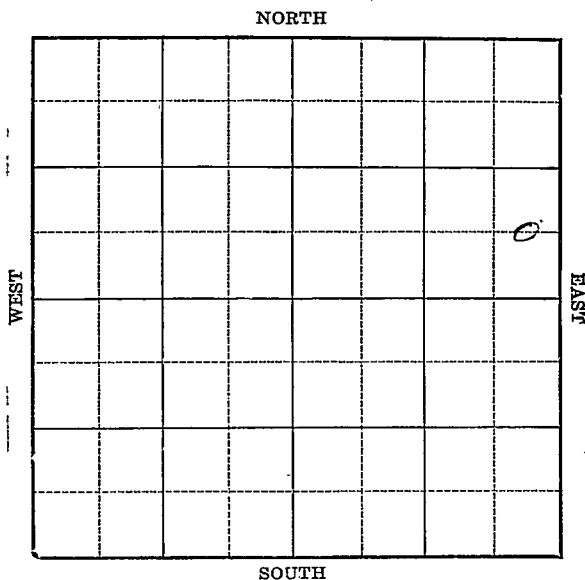

Location_____

Drilling Remarks

Rig Up_____

Drilling Remarks

RECORD

Cased_____in. _____ft.

Sand_____

Gas_____

Oil_____

Total Depth_____

PRODUCTION

1st 24 hrs. Nat._____

1st 24 hrs. after shot_____

Gas_____cu. ft.

Dry Hole_____

Abandoned_____

McPherson

Map No. KANSAS Sec. 1 Twp 20 R. 24

Well No. 2 Flook Farm


Jones et al. Company

 Ft. from N. Line

660 Ft. from S. Line

320' Ft. from E. Line

 Ft. from W. Line

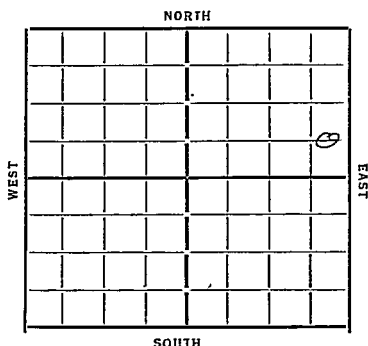

Date 1933

REPORT

12/13 Qellar
12/27 — 1/11 — 1/17 —
1/27 R.O. 1/31 —
2/7 —
2/14 B R
2/23 Rigging Up
3/1 — 3/8 — 3/15 —
3/22 — 3/29 — 4/5 —
4/12 — 4/19 — 4/26 —
5/3 dlg 162 15 1/2" 73'
5/10 —
5/18 dlg 1385
5/25 7 kg 1485
6/6 TD 1385 abh.

ABANDONED

Map No. 43 Sec. 1 Twp. 20 R. 2W

Well No. 2-Flook

Jones et al Company

~~FIRST REPORTS~~ Contractor

SECTION PLAT

			0

.....Ft. from N. Line
660 Ft. from S. Line
330 Ft. from E. Line
.....Ft. from W. Line

Location.....

Rig up.....

Drilling and Remarks:

cellar

RECORD

Cased.....in.,ft.
Sand.....
Gas.....
Oil.....
Total Depth.....

PRODUCTION

1st 24 hrs. Nat.....
1st 24 hrs. after shot.....
Gas.....Cu. Ft.
Dry Hole.....
Abandoned.....

Date

12-13-33 192 C. Mannschreck Scout

Map No. 43 Sec. 1 Twp. 20 R. 2WWell No. 2- OilcoakJones Etal CompanyABANDONED Contractor

SECTION PLAT

			0

 Ft. from N. Line660 Ft. from S. Line330 Ft. from E. Line Ft. from W. LineLocation Rig up

Drilling and Remarks:

and

RECORD

Cased in., ft.Sand Gas Oil Total Depth 1385

PRODUCTION

1st 24 hrs. Nat. 1st 24 hrs. after shot Gas Cu. Ft.Dry Hole Abandoned

Date

6-3-19ORVAL MANNSCHRECK
Scout