


Section 1 Township 20 Range 2-WWell No. #2 FlookCompany L C Crow etal
Ritz-Canton Pool

NORTH

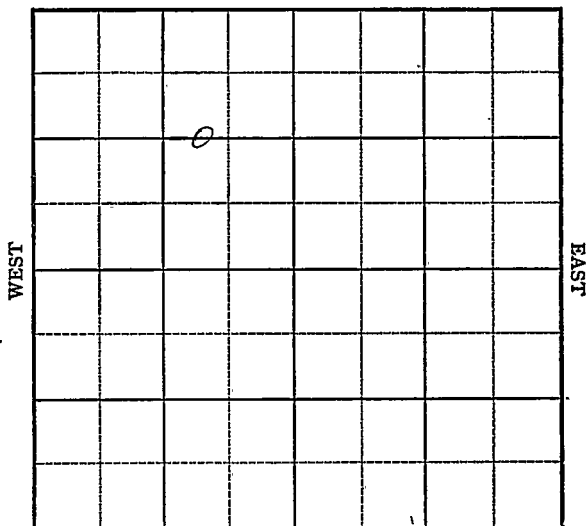

SOUTH

Sec. 1 Twp. 20 R. 2-W

Well No. #2 Flook Farm

L C Crow et al Company

Contractor

Ritz- Canton Pool


1320 Ft. from N. Line

 Ft. from S. Line

990 Ft. from E. Line

 Ft. from W. Line

C W L E $\frac{1}{2}$ NW

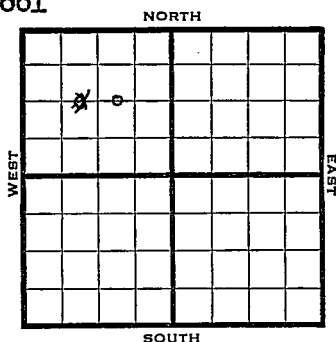

1949 Elev 1546' REPORT

11/9 8" @ 134'
Drlg 670'
11/16 Chat 2928-29'
TD 2929'
5" @ 2929'
11/23 TD 2940'
500 acid
11/30 TD 2960'
Chat 2928'
5 @ 2929'
Aband.

ABANDONED

Kansas

Map No. _____ Sec. 1 Twp. 20 R. 2WWell No. 2 Flook_____
L. C. Crow et al. _____ Company_____
ContractorC. W. L. E $\frac{1}{2}$ NWFIRST REPORT
SECTION PLAT1320 Ft. from N. Line

_____ Ft. from S. Line

990 Ft. from E. Line

_____ Ft. from W. Line

McPherson County

Location _____

Rig up _____

Drilling and Remarks:

8" @ 134'

drlg. 670'

RECORD

Cased _____ in., _____ ft.

Sand _____

Gas _____

Oil _____

Total Depth _____

PRODUCTION

1st 24 hrs. Nat. _____

1st 24 hrs. after shot _____

Gas _____ Cu. Ft.

Dry Hole _____

Abandoned _____

Date

NOV 9 1949

19

S. J. LEWIS


Scout

Kansas

Ritz-Canton Pool

Map No. _____ Sec. 1 Twp. 20 R. 2WWell No. 2 Flook_____
L. C. Crow et al. _____ Company

ABANDONED

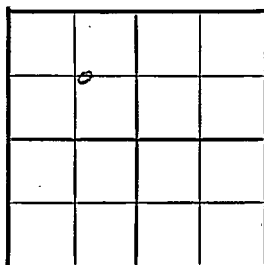ContractorC W L E $\frac{1}{2}$ NW*E. 1546*
SECTION PLAT_____
1320 Ft. from N. Line_____
Ft. from S. Line_____
990 Ft. from E. Line_____
Ft. from W. Line

McPherson County

Location _____

Rig up _____

Drilling and Remarks:

*Chas 2928**5" 02928*

RECORD

Cased _____ in., _____ ft.

Sand _____

Gas _____

Oil _____

Total Depth 2960

PRODUCTION

1st 24 hrs. Nat. _____

1st 24 hrs. after shot _____

Gas _____ Cu. Ft.

Dry Hole _____

Abandoned _____

Date

NOV 30 1949 19

S. J. LEWIS Scout