


M. E. Pherson
 Map No. KANSAS Sec. 1 Twp. 20 R. 2W
 Well No. 3- Hook Farm
Dixie & Ambrada Company

NORTH

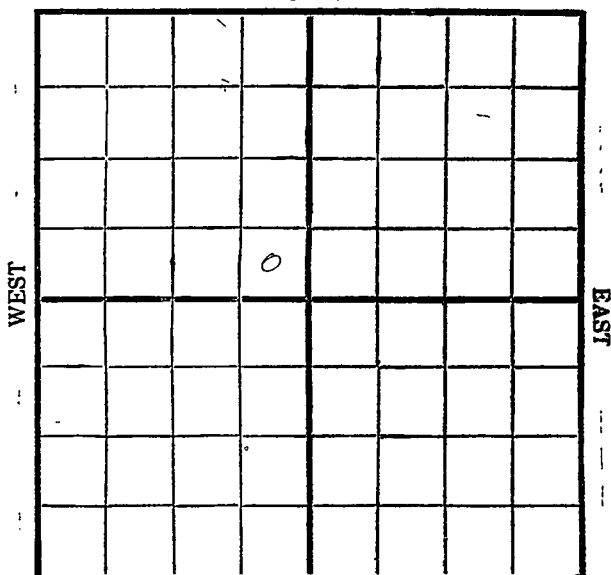

SOUTH

Location _____

Drilling Remarks _____

Rig Up _____

Drilling Remarks _____

RECORD

Cased _____ in. _____ ft.

Sand _____

Gas _____

Oil _____

Total Depth _____

PRODUCTION

1st 24 hrs. Nat. _____

1st 24 hrs. after shot _____


Gas _____ cu. ft.

Dry Hole _____

Abandoned _____

Map No. KANSAS Sec. 1 Twp. 20 R. 2^w
Well No. 3- Hook Farm
Line & Ambedu Company

 Ft. from N. Line
300 Ft. from S. Line
300 Ft. from E. Line
1930 Ft. from W. Line

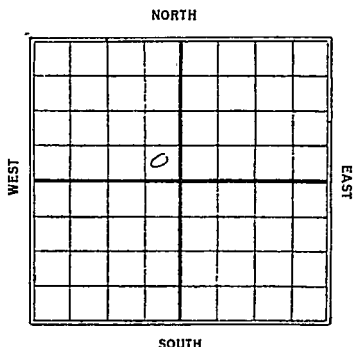

Date REPORT

Date	REPORT
10/8	Loc
10/15	Tr
10/22	Drill 635'
10/29	515 635'
11/5	Never was 635'-
	Only a rig
11/12	Rig
11/19	1490 up
11/25	Sur. pipe 159'
12/3	Drill 1820'
12/10	" 2530
12/17	Chat 2935-40'
	Crust
12/24	Chat 2937-66
	TD 2966
	flow 2000 bbl oil
	2 nd gas
	Comp.

McPherson
 Map No. **KANSAS** Sec. 1 Twp. 20 R. 24
43
 Well No. 3 Flork.

Lizie & Cameron Company
 Contractor

SECTION PLAT

.....Ft. from N. Line
300 Ft. from S. Line
300 Ft. from E. Line
Ft. from W. Line

	0		

FIRST REPORTS

Location ✓

Rig up

Drilling and Remarks:

RECORD

Cased.....in., ...ft.

Sand.....

Gas.....

Oil.....

Total Depth.....

PRODUCTION

1st 24 hrs. Nat.....

1st 24 hrs. after shot.....

Gas.....Cu. Ft.

Dry Hole.....

Abandoned.....

Date

OCT 8 1930


S. J. LEWIS Scout

Map No. **KANSAS** Sec. 1 Twp. 20 R. 2 N
 Well No. 43
8 Flook

Hill & Amersala Company

Contractor

SECTION PLAT

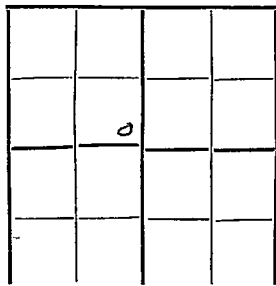

Ft. from N. Line

300 Ft. from S. Line

300 Ft. from E. Line

Ft. from W. Line

COMPLETED

Location

Rig up Chas

Drilling and Remarks:

Flow 2000 bbl.

2 M Gas.

RECORD

Cased _____ in., _____ ft.

Sand 2937 - 66

Gas _____

Oil _____

Total Depth 2966

PRODUCTION

1st 24 hrs. Nat. _____

1st 24 hrs. after shot _____

Gas _____ Cu. Ft.

Dry Hole _____

Abandoned _____

Date

DEC 2 1930

192

S. J. LEWIS

Scout