


Form 51-5M-2-29-34703

Map No. KANSAS Sec. 1-16-13 Twp. 20 R. 2W

Well No. McPherson O & L Farm _____ Company _____

NORTH

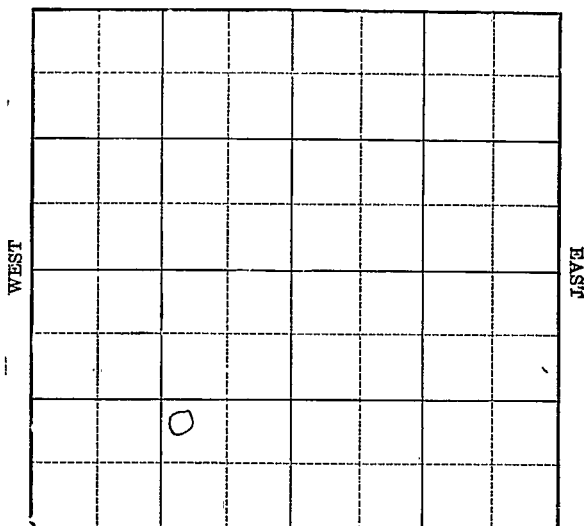

SOUTH

Location _____
Drilling Remarks _____

Rig Up _____
Drilling Remarks _____

RECORD


Cased _____ in. _____ ft.
Sand _____
Gas _____
Oil _____
Total Depth _____

PRODUCTION

1st 24 hrs. Nat. _____
1st 24 hrs. after shot _____
Gas _____ cu. ft. _____
Dry Hole _____
Abandoned _____

Map No. KANSAS Sec. 16 Twp. 20 R. 2 W
Well No. 1-1617 Farm
M^cPherson Oil Co Company

 Ft. from N. Line
1170 Ft. from S. Line
1170 Ft. from E. Line
 Ft. from W. Line

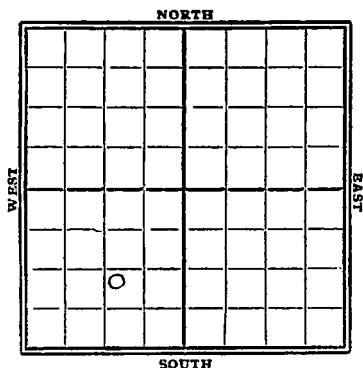

1929

Date	REPORT
3/20	Bldg Rtg
3/27	Rign up
4/13	
4/10	urlg 410
4/17	" 850'
4/24	" 1350'
5/1	" 1547
5/8	" 1822'
5/15	" 1850'
5/22	" 2244'
	HFW 2133'
5/29	HFW 2447-53 urlg 2453
6/5	urlg 2665'
6/12	urlg 2780'
6/19	urlg 2905'
7/1	2p chat 2935'
	Oil 2960-66 flow
	368 bbls in 1 hr 35 min
	pinched in and made
	193 bbls 2 hrs
	3 to 4 m gas 34.7 grav.
	(over)

- 7/2 - flowed 1091 bbls
last 24 hrs pinched
thro' 2" line
- 7/10 - flow 1092 bbls oil
1% water 1/4% B.S.
- 7/17 - Top chat 2935'
Pay 2960-66'
T.D. 2966'
1100 bbls pinched
344 gas
Pump.
- 7/19 - Opened 7 minutes
Flowed at rate of
7000 bbl per day
34.5 gravity oil

MAP No. KANISAS SEC. 1 TWP. 20 R. 2 W

WELL No. 1 Ritz

McPherson O & G COMPANY

CONTRACTOR

SECTION PLAT

	0		

Ft. FROM N. LINE

1170 Ft. FROM S. LINE

1170 Ft. FROM E. LINE

Ft. FROM W. LINE

FIRST REPORTS

LOCATION

RIG UP

DRILLING AND REMARKS:

Building rig

RECORD

CASED _____ IN. _____ FT.

SAND _____

GAS _____

OIL _____

TOTAL DEPTH _____

PRODUCTION

1ST 24 HRS. NAT. _____

1ST 24 HRS. AFTER SHOT _____

GAS _____ CU. FT.

DRY HOLE _____

ABANDONED _____

DATE

MAR 20 1929

S. J. LEWIS SCOUT

McPherson

Map No. **KANSAS** Sec. 1 Twp. 20 R. 24Well No. 43 1 RitzMcPherson O & G Company

Contractor

SECTION PLAT

Ft. from N. Line

1170 Ft. from S. Line1170 Ft. from E. Line

Ft. from W. Line

	0		

COMPLETED

Location.....

Rig up.....

Drilling and Remarks:

Top @ 2935Pay 2960-661100 lbs. punchedin3 M Gas

RECORD

Cased.....in.,ft.

Sand.....

Gas.....

Oil.....

Total Depth 2966

PRODUCTION

1st 24 hrs. Nat.....

1st 24 hrs. after shot.....

Gas.....Cu. Ft.

Dry Hole.....

Abandoned.....

Date

JUL 17 1929192S. J. LEWIS

Scout