

Map No. KANSAS Sec. 1 Twp. 20 R. 2ndWell No. 1-1100 FarmJ. F. Jones & Shell Company

NORTH

WEST

EAST

SOUTH

Location _____

Drilling Remarks

Rig Up _____

Drilling Remarks

RECORD

Cased _____ in. _____ ft.

Sand _____

Gas _____

Oil _____

Total Depth _____

PRODUCTION

1st 24 hrs. Nat. _____

1st 24 hrs. after shot _____

Gas _____ cu. ft.


Dry Hole _____

Abandoned _____

Map No. KANSAS Sec. 1 Twp. 20 R. 2w

Well No. 1 - Flook Farm
E. F. Jones & Shull Company

NORTH

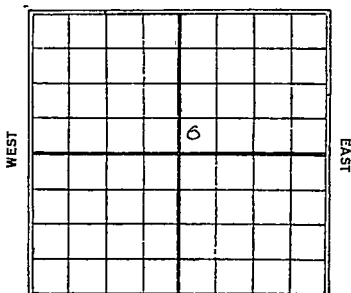

Ft. from N. Line

330 Ft. from S. Line

Ft. from E. Line

330 Ft. from W. Line

1930

Date

REPORT

10/8	Loc
10/15	P.G.
10/22	P.G.
10/29	P.G.
11/5	Right up
11/12	—
11/19	—
11/25	—
12/3	Only 870'
12/10	" 12"-1391
	Only 1430
12/17	" 2015
12/23	" 2390
12/30	U/R 8"-2555
1931	—
1/7	Run 8"-2555
1/14	Top Chat 2949
	18"-2951' P.B.P.
1/21	Top Chat 2938 (52m).
	TD. 2940' U/R 6"
	(over)

1/28. Chat 2938-81

.T.D. 2981

flow 2738 bbl net
24 hrs

2 1/2 At gas

cut 35% water

Comp.

Map No. **KANSAS** Sec. 1 Twp. 20 R. 2 W

Well No. 43 1 Flood

E. F. Jones & Shell Company

Contractor

SECTION PLAT

		0	

Ft. from N. Line

820 Ft. from S. Line

Ft. from E. Line

820 Ft. from W. Line

FIRST REPORTS

Location ✓

Rig up

Drilling and Remarks:

RECORD

Cased _____ in., _____ ft.

Sand _____

Gas _____

Oil _____

Total Depth _____

PRODUCTION

1st 24 hrs. Nat. _____

1st 24 hrs. after shot _____

Gas _____ Cu. Ft.

Dry Hole _____

Abandoned _____

Date

OCT 8 1930 92 S. J. LEWIS Scout

Map No. 43 KANSAS Sec. 1 Twp. 20 R. 2 W

Well No. 1 Flook

E. F. Jones & Shell Company

Contractor

SECTION PLAT


300 Ft. from N. Line

300 Ft. from S. Line

800 Ft. from E. Line

800 Ft. from W. Line

COMPLETED

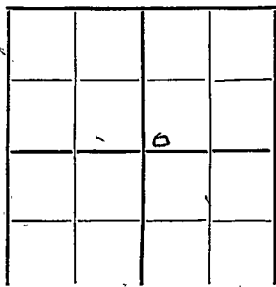

Location.....

Rig up.....

Drilling and Remarks:

Flow 273888k

Net. 24 hrs.

300 water

RECORD

Cased.....in.,ft.

2938 - 2981

Gas 2 1/2 M.

Oil.....

Total Depth 2981

PRODUCTION

1st 24 hrs. Nat.....

1st 24 hrs. after shot.....

Gas.....Cu. Ft.

Dry Hole.....

Abandoned.....

Date

JAN 28 1921

S. J. LEWIS Scout