

KANSAS


Form 51—5M—7-40—Palace

Rice

Section 10 Township 20 Range 9-W

Well No. #1 Keesling

Company Colorado Petr. Co., Inc.
Sharon Drilling

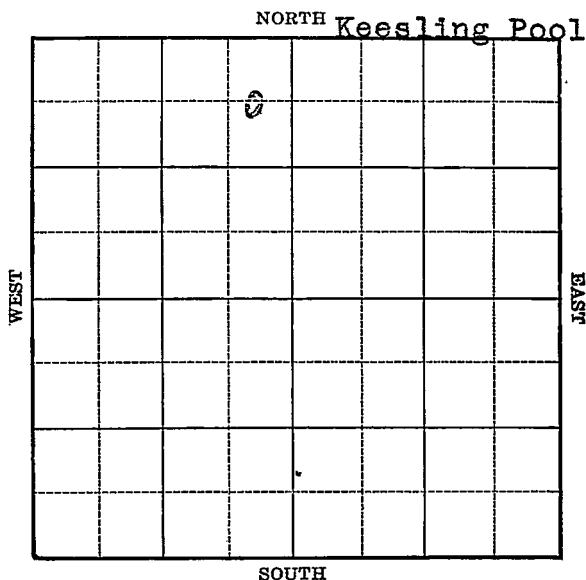

KANSAS

Rice


Sec. 10 Twp. 20 R. ~~6~~ 9-WWell No. 1 Keesling FarmColorado Petr. Co., Inc.Sharon Dlg.

Company

(Keesling Pool)

660 Ft. from N. Line Ft. from S. Line330 Ft. from E. Line Ft. from W. Line

Elev. 1694

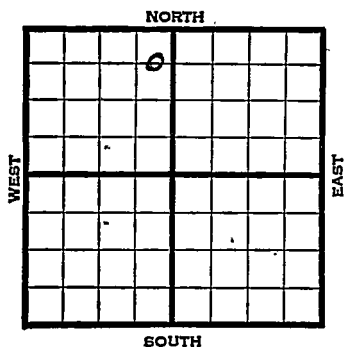

1940

REPORT

8/28 Dlg. 815 8" 195

9/5 Drlg. 2895'

9/12 Dodge 2850' Lams. 2875'

Arb. 3206' T.D. 3215'

4" - 3208' RUST.

9/19 Pay 3220-21' T.D. 3232½'

Swab 45 bbls. 8 hours.

Shot 10 qts. 1000' oil.

9/26 7000 acid. Swab 10 bbls. per hr

10/3 Swab 27 bbls. 3 hours.

10/10 Pump 340 bbls. in 39 hours.

10/16 Arb. 3206'

5" - 3208'

T.D. 3232½'

Shot 10 qts.

7000 acid.

Potential 390 bbls., pump.

COMPLETED

Map No. 49 Sec. 10 Twp. 20 R. 9W

Well No. 1 Keesling

Sharon Drilling Company

Contractor

FIRST REPORT
C E L NE NW

660 Ft. from N. Line

_____ Ft. from S. Line

330 Ft. from E. Line

_____ Ft. from W. Line

SECTION PLAT

KEESLING POOL

Location _____

Rig up _____

Drilling and Remarks:

8" - 195

Dr1g. 815

RECORD

Cased _____ in., _____ ft.

Sand _____

Gas _____

Oil _____

Total Depth _____

PRODUCTION

1st 24 hrs. Nat. _____

1st 24 hrs. after shot _____

Gas _____ Cu. Ft.

Dry Hole _____

Abandoned _____

Date

AUG 28 1940₁₉

S. J. LEWIS Scout

Map No. 49 Sec. 10 Twp. 20 R. 9WWell No. 1 KeeslingColorado Petroleum Co. Inc. CompanyCORRECTION Contractor

C E L N E NW

660 Ft. from N. Line Ft. from S. Line330 Ft. from E. Line Ft. from W. Line

KEESLING POOL

SECTION PLAT

Location Rig up

Drilling and Remarks:

Reported as

Sharon Drlg. Cp.

RECORD

Cased in., ft.Sand Gas Oil Total Depth

PRODUCTION

1st 24 hrs. Nat. 1st 24 hrs. after shot Gas Cu. Ft.Dry Hole Abandoned

Date

SEP 5 1940 19 S. I. LEWIS Scout

Map No. 49 Sec. 10 Twp. 20 R. 9WWell No. 1 KeeslingColorado Petroleum Co., Inc.
Company

Contractor

COMPLETED**SECTION PLAT**

C E L NE NW

660 Ft. from N. Line Ft. from S. Line330 Ft. from E. Line Ft. from W. Line

KEESLING POOL

		6	

Location Rig up

Drilling and Remarks:

*CR 8206**5" 8208**109 to**5000 acrol**Pump 390 P.D.***RECORD**Cased in., ft.Sand Gas Oil Total Depth 3232 1/2**PRODUCTION**1st 24 hrs. Nat. 1st 24 hrs. after shot Gas Cu. Ft.Dry Hole Abandoned

Date

OCT 16 1940 19S. J. LEWIS Scout