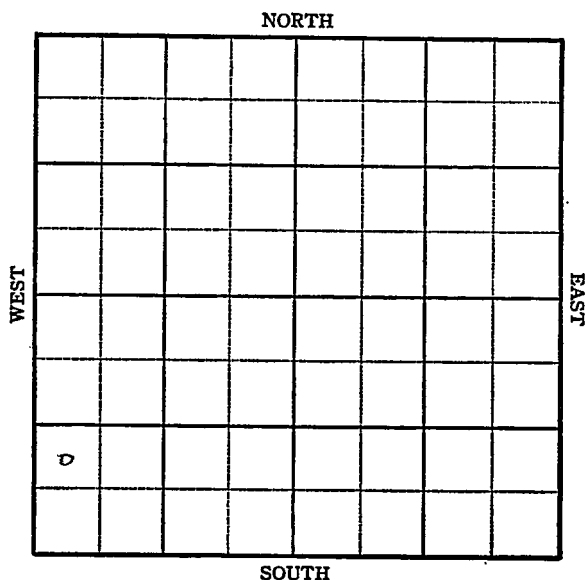


KANSAS

Rice


Section 10 Township 20 Range 9WWell No. 1 Keesling "A"Company C. U. Bay

KANSAS

Rice County

Sec. 10 Twp. 20 R. 9WWell No. #1 Keesling "A" FarmC. U. Bay Company

Silica

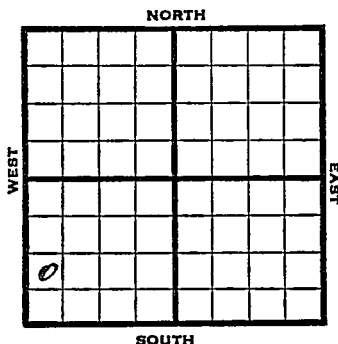 Ft. from N. Line990 Ft. from S. Line Ft. from E. Line330 Ft. from W. Line

NW SW SW - - - "

1945 Elev. 1712 REPORT

10/31 Gulf Farm out
8" @ 200
Drlg. 1340

11/7 Drlg. 2770'

11/14 Arb. 3219-3222
TD 3222
5" @ 3221 RUST

11/21 TD 3236
Swab 5 oil per hr.

11/28 " " "

12/5 Arb. 3219
5" @ 3221
TD 3236
Pump 100 Pot.
Grav. 42.3

COMPLETED

KANSAS

Kansas Pool Name SilicaMap No. 49 Sec. 10 Twp. 20 R. 9WWell No. 1 Keesling "A"

C. U. Bay

Company

FIRST REPORT

Contractor

NW SW SW

SECTION PLAT

 Ft. from N. Line

990

 Ft. from S. Line Ft. from E. Line

330

 Ft. from W. Line

o			

Rice CountyLocation Rig up

Drilling and Remarks:

Gulf farm cut

8"-200'

1340

RECORD

Cased in., ft.Sand Gas Oil Total Depth

PRODUCTION

1st 24 hrs. Nat. 1st 24 hrs. after shot Gas Cu. Ft.Dry Hole Abandoned

Date

OCT 31 1945

19

S. J. LEWIS

Scout

KANSAS Kansas Pool Name SilicaMap No. K 49 Sec. 10 Twp. 20 R. 9WWell No. 1 Keesling "A"C. U. Bay Company**COMPLETED**

Contractor

NW SW SW

E 1/12
SECTION PLAT Ft. from N. Line990 Ft. from S. Line Ft. from E. Line330 Ft. from W. Line

0			

Rice CountyLocation Rig up

Drilling and Remarks:

Art 3219
5' 03221
Pump 100 328

RECORDCased in., ft.Sand Gas Oil Total Depth 3236**PRODUCTION**1st 24 hrs. Nat. 1st 24 hrs. after shot Gas Cu. Ft.Dry Hole Abandoned

Date

DEC 5 1945

19

S. J. LEWIS

Scout