

KANSAS


Rice

Section 10 Township 20 Range 9N

Well No. 1 Kessler

Company Harms et al

Chase
NORTH

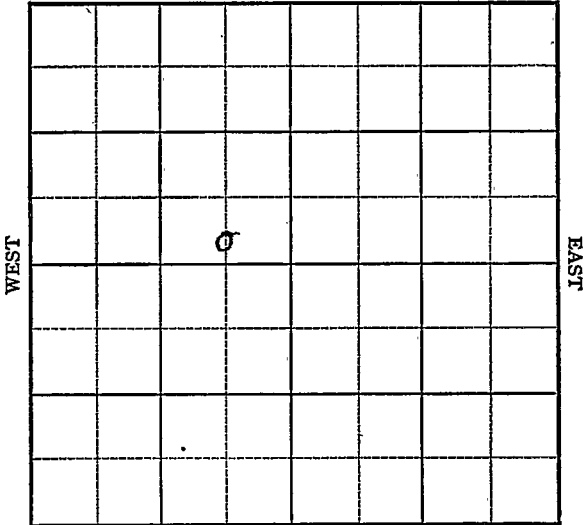

SOUTH

KANSAS

Rice

HOT FILE ✓

Sec. 10 Twp. 20 R. 9W

Well No. #1 Kessler Farm

Harms et al

Company

Chase Pool


 Ft. from N. Line

330' Ft. from S. Line

660' Ft. from E. Line

 Ft. from W. Line

C. S L SE NW

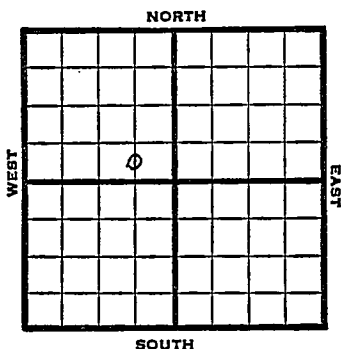

1949

Elev 1693'

REPORT

4/6

8" @ 215'

Drlg. 2270'

4/12

Arbuckle 3211'

TD 3217'

4/20

TD 3234'

3000 acid

4/27

"

5/4

1000 acid

Swb 30 bbls oil & 200 W

5/10

"

5/17

"

5/25

"

6/1

"

6/7

"

6/14

"

6/21

"

6/29

TD 3234'

Arb. 3211'

Aband.

ABANDONED

Map No. _____ Sec. 10 Twp. 20 R. 9W

Well No. 1 Kessler

Harms et al. Company

FIRST REPORT Contractor

C S L SE NW


SECTION PLAT

_____ Ft. from N. Line

330 Ft. from S. Line

660 Ft. from E. Line

_____ Ft. from W. Line

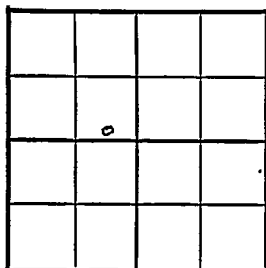

Rice County

Location _____

Rig up _____

Drilling and Remarks:

8" @ 215

drlg. 2270

RECORD

Cased ~~in~~ in. _____ ft.

Sand _____

Gas _____

Oil _____

Total Depth _____

PRODUCTION

1st 24 hrs. Nat. _____

1st 24 hrs. after shot _____

Gas _____ Cu. Ft.

Dry Hole _____

Abandoned _____

Date

APR 6 1949 19

S. J. LEWIS Scout

Map No. K49 Sec. 10 Twp. 20 R. 9W

Well No. 1 Kessling

Harms et al. Company

ABANDONED Contractor

C S L SE NW


E 11693
SECTION PLAT

 Ft. from N. Line

330 Ft. from S. Line

660 Ft. from E. Line

 Ft. from W. Line

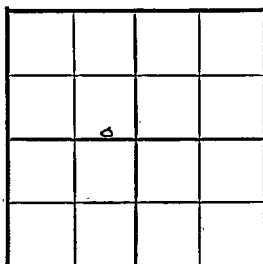

Rice County

Location

Rig up

Drilling and Remarks:

Cer 83211

RECORD

Cased in., ft.

Sand

Gas

Oil

Total Depth 2234

PRODUCTION

1st 24 hrs. Nat.

1st 24 hrs. after shot

Gas Cu. Ft.

Dry Hole

Abandoned

Date

JUN 29 1949 19

S. J. LEWIS Scout