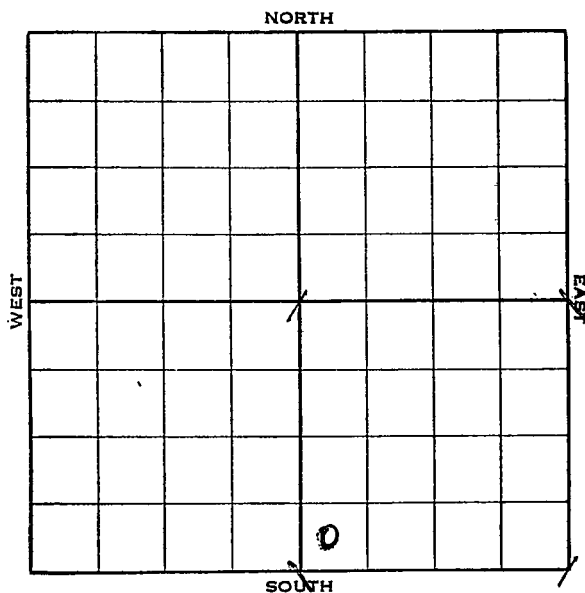


Rice

KANSAS

Section 10 Township 20 Range 9-WWell No. 1 Johnson PetersonCompany Texon

KANSAS

Rice

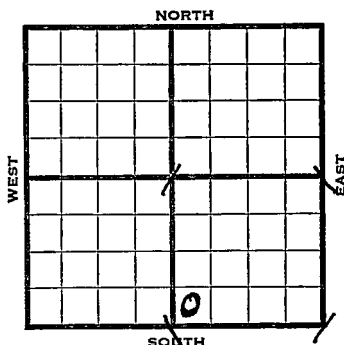
Sec. 10 Twp. 20 R. 9-WWell No. #1 Johnson Peterson FarmTexon

Company

Ft. from N. Line

330 Ft. from S. Line

Ft. from E. Line

330 Ft. from W. Line

Elev. 1694'.

1938	REPORT
10/12	B.R.R.
10/21	10" - 241'. WOC.
10/28	Dlg. 2560'.
11/4	Arb. 3208'. T. D. 3220'. S. O. 7" - 3210'. RUST.
11/12	T. D. 3225'. 1600' oil 24 hrs.
11/18	T. D. 3228'. 1000' acid. Swab 22 oil 2 hours.
11/25	3000 acid. T.D. 3228'.
11/30	7" - 3210'. Arb. 3208'.
	T. D. 3228'. 4000 acid.
	Pump 226 bbls. 8 hours.
	Potential 678 bbls.
	COMPLETED

Rice

KANSAS

Map No. 44 Sec. 10 Twp. 20 R. 9WWell No. 1 JohnsonTexon

Company

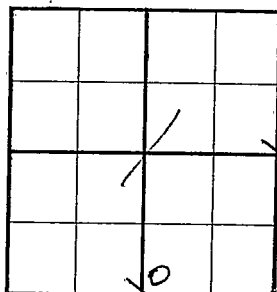
Contractor

FIRST REPORT

SW SE

 Ft. from N. Line330 Ft. from S. Line Ft. from E. Line330 Ft. from W. Line

SECTION PLAT

Location Rig up

Drilling and Remarks:

BRR

RECORD

Cased in., ft.Sand Gas Oil Total Depth

PRODUCTION

1st 24 hrs. Nat. 1st 24 hrs. after shot Gas Cu. Ft.Dry Hole Abandoned

Date

OCT 12 1938

19

H. D. Hatfield

Scout

Rice

KANSAS

Map No. 49 Sec. 10 Twp. 20 R. 9WWell No. 1 Johnson

Texon

Company

Contractor

COMPLETED

SECTION PLAT

SW SE

_____ Ft. from N. Line

330 Ft. from S. Line

_____ Ft. from E. Line

330 Ft. from W. Line

		0	

Location _____

Rig up _____

Drilling and Remarks:

4000 Acid

Pump 226/8

Pot 678

RECORD

Cased 7 in., 3210 ft.Sand Arb 3208

Gas _____

Oil _____

Total Depth 3228

PRODUCTION

1st 24 hrs. Nat. _____

1st 24 hrs. after shot _____

Gas _____ Cu. Ft.

Dry Hole _____

Abandoned _____

Date

NOV 30 1938 19 H. D. Hatfield Scout

KANSAS

Map No. 49 Sec. 10 Twp. 20 R. 9^wWell No. 1-PetersonTelson Company

Contractor

sw se
CORRECTION Ft. from N. Line350 Ft. from S. Line Ft. from E. Line350 Ft. from W. Line

SECTION PLAT

		0	

Location Rig up

Drilling and Remarks:

Farm Name
 changed from
 Johnson to Peterson

RECORD

Cased in., ft.Sand Gas Oil Total Depth

PRODUCTION

1st 24 hrs. Nat. 1st 24 hrs. after shot Gas Cu. Ft.Dry Hole Abandoned

Date

MAR 8 - 1939 19

H. D. Hatfield Scout