

KANSAS

Form 51-5M-7-40-Palace


Rice

Section 10 Township 20 Range 9-W

Well No. #1 Tappan

Company Colorado Petroleum

NORTH Keesling Pool

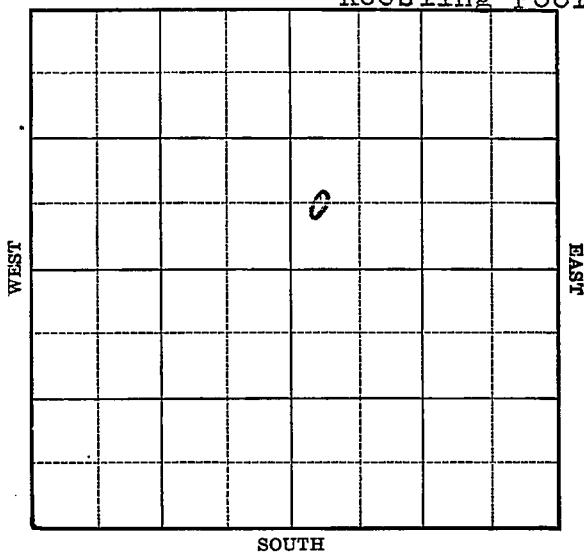

Map No. 49 Sec. 10 Twp. 20 R. 9WWell No. 1 TappanColorado Petroleum

Company

Contractor

FIRST REPORT

C W L SW NE

SECTION PLAT

 Ft. from N. Line660 Ft. from S. Line Ft. from E. Line330 Ft. from W. Line

KEFSLING POOL

Location XRig up

Drilling and Remarks:

RECORDCased in., ft.Sand Gas Oil Total Depth **PRODUCTION**1st 24 hrs. Nat. 1st 24 hrs. after shot Gas Cu. Ft.Dry Hole Abandoned

Date

NOV 20 194019S. J. LEWIS Scout

Map No. 49 Sec. 10 Twp. 20 R. 9WWell No. 1 TeppanColorado Petroleum Company

Contractor

COMPLETED

C W L SW NE

 Ft. from N. Line660 Ft. from S. Line Ft. from E. Line330 Ft. from W. Line

KEESLING POOL

SECTION PLAT

Location Rig up

Drilling and Remarks:

*Cr 8-3216**5" C 3218**2896 skt.**1000 acid**Pump. 406 Pk**435 Gr*

RECORD

Cased in., ft.Sand Gas Oil Total Depth 3248

PRODUCTION

1st 24 hrs. Nat. 1st 24 hrs. after shot Gas Cu. Ft.Dry Hole Abandoned

Date

DEC 23 1940 19S. J. LEWIS

Scout