

KANSAS


Form 51—5M—7-40—Palace

Rice

Section 10 Township 20 Range 9-W

Well No. #3 Anna

Company C. B. Davis

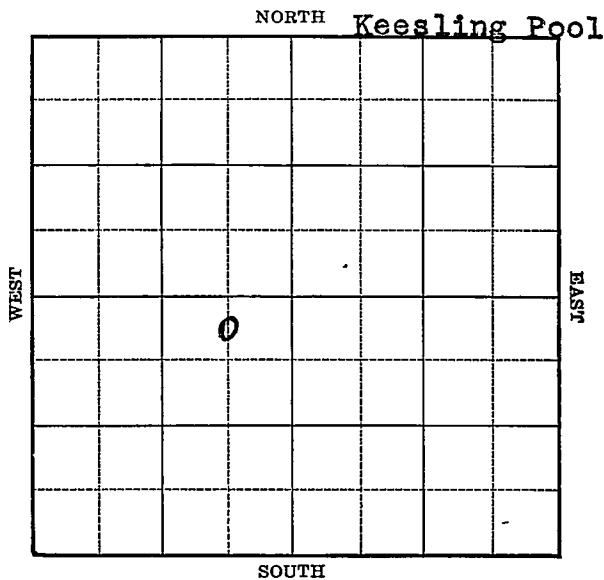

KANSAS


Rice

Sec. 10 Twp. 20 R. 9-WWell No. #3 Anna FarmC. B. Davis Company

(Keesling)

330 Ft. from N. Line Ft. from S. Line660 Ft. from E. Line Ft. from W. Line

Elev. 1695

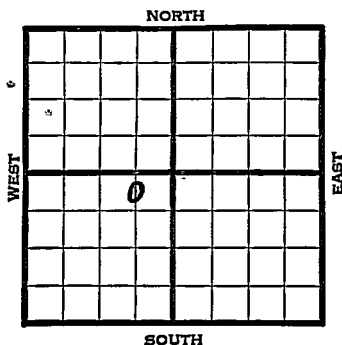

1941

REPORT

2/26

Location

3/6

Cellar.

3/13

"

3/20

Surface hole.

3/27

8" - 221' Drlg. 2550'

4/3

Arb. 3215' 5" - 3220'

T.D. 3223' RUST.

4/10

Arb. 3215' (Corrected)

5" - 3216' T.D. 3226' 10000

acid. 2800' oil.

4/18

Pump 56 oil 8 hours.

4/24

TD 3230½' SD.

OVER

1941

4/30

Arb. 3215'

5" - 3216'

T.D. 3230 $\frac{1}{2}$ '

Shot 60 qts.

1000 acid.

Potential 250 b bls., pump.

43.8 Gravity

COMPLETED

Map No. 49 Sec. 10 Twp. 20 R. 9WWell No. 3 AnnaC. B. Davis CompanyFIRST REPORT Contractor

SECTION PLAT

330 C N L NE SW
Ft. from N. Line

Ft. from S. Line

660 Ft. from E. Line

Ft. from W. Line

KEESLING POOL

	0		

Location X

Rig up

Drilling and Remarks:

RECORD

Cased _____ in., _____ ft.

Sand _____

Gas _____

Oil _____

Total Depth _____

PRODUCTION

1st 24 hrs. Nat. _____

1st 24 hrs. after shot _____

Gas _____ Cu. Ft.

Dry Hole _____

Abandoned _____

Date

FEB 26 1911 19S. J. LEWIS Scout

Map No. 49 Sec. 10 Twp. 20 R. 9WWell No. 3 AnnaC. B. Davis Company**COMPLETED** Contractor**SECTION PLAT**

C N L NE SW

	o		

330 Ft. from N. Line Ft. from S. Line660 Ft. from E. Line Ft. from W. Line**KEESLING POOL**Location Rig up

Drilling and Remarks:

*ax 3215**5" @ 3216**60 ft.**wood acid**Pump 250 P.S.**43 E L***RECORD**Cased in., ft.Sand Gas Oil Total Depth 3230 1/2**PRODUCTION**1st 24 hrs. Nat. 1st 24 hrs. after shot Gas Cu. Ft.Dry Hole Abandoned

Date

APR 30 1941S. J. LEWIS Scout.