

KANSAS

Form 51-5M-7-40-Palace

Rice


Section 10 Township 20 Range 9-W

Well No. #1 Tappan

Company Sharon Drilling

Keesling Pool

NORTH

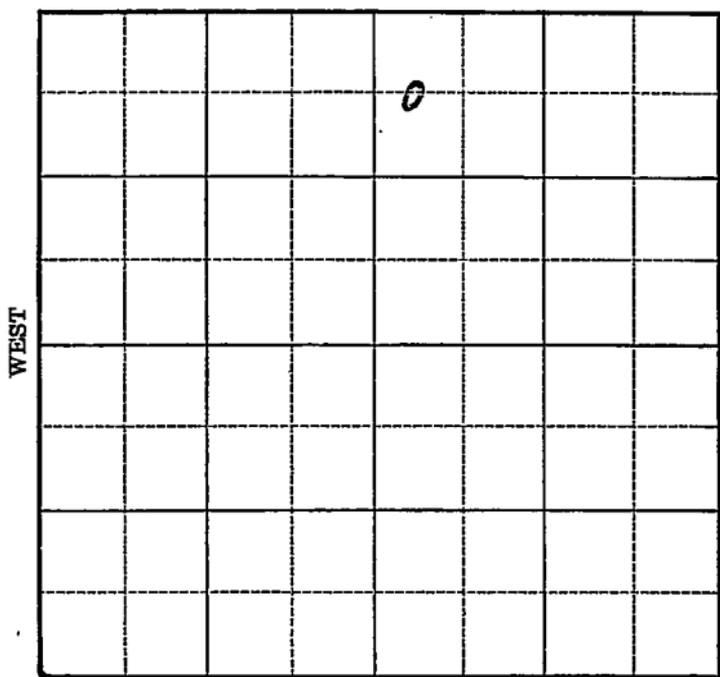

SOUTH

WEST

EAST

Map No. 49 Sec. 10 Twp. 20 R. 9WWell No. 1 TappanSharon Drilling Company

Contractor

COMPLETED**SECTION PLAT**C W L NW NE
660 Ft. from N. Line Ft. from S. Line Ft. from E. Line330 Ft. from W. Line

| | | | |
|--|--|--|--|
| | | | |
| | | | |
| | | | |
| | | | |

KEESLING POOL

Location _____

Rig up _____

Drilling and Remarks:

*Ar & 3222**5' @ 3223**Pump 415 P.Y.***RECORD**

Cased _____ in., _____ ft.

Sand _____

Gas _____

Oil _____

Total Depth 3240**PRODUCTION**

1st 24 hrs. Nat. _____

1st 24 hrs. after shot _____

Gas _____ Cu. Ft.

Dry Hole _____

Abandoned _____

Date

OCT 23 1940

19

S. J. LEWIS

Scout