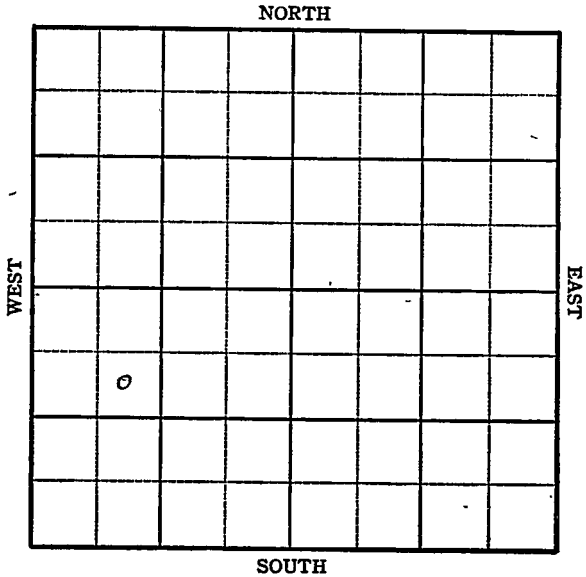


KANSAS

Rice

FORM 51 5M PETROL

Section 10 Township 20 Range 9WWell No. 2 Keesling "A"Company C. U. Bay

Sec. 10 Twp. 20 R. 9-W

Well No. #2 Keesling "A" Farm


C. U. Bay Company

990 Ft. from N. Line

Ft. from S. Line

Ft. from E. Line

990 Ft. from W. Line

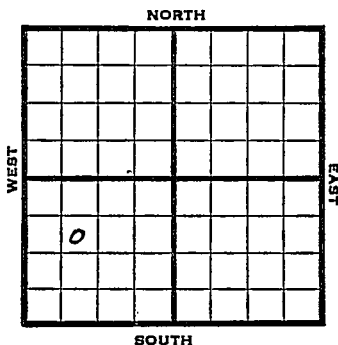

SE NW SW

1945

Elev. 1704

REPORT

11/7 Location

11/14 8" @ 183

Drig. 1164'

11/21 Drig. "2950'

11/28 Arb. 3219-3222

TD 3222

5" @ 3221 RUST

12/5 TD 3234

500 acid.

Swb. 2oil plus 5 Wtr. per hr.

12/12 " " " " "

12/20 " "

12/28 Arb. 3219

5" @ 3221

500 acid.

TD 3234

Pump 30 Pot.


Grav. 42.0

COMPLETED

KANSAS Kansas Pool Name SilicaMap No. 49 Sec. 10 Twp. 20 R. 9WWell No. 2 Keesling "A"C. U. Bay CompanyFIRST REPORT Contractor

SE NW SW

SECTION PLAT

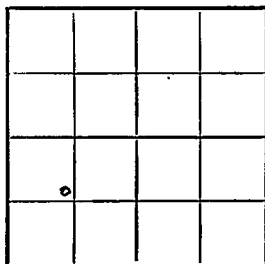990 Ft. from N. Line Ft. from S. Line Ft. from E. Line990 Ft. from W. LineRice CountyLocation XRig up

Drilling and Remarks:

RECORD

Cased in., ft.Sand Gas Oil Total Depth

PRODUCTION

1st 24 hrs. Nat. 1st 24 hrs. after shot Gas Cu. Ft.Dry Hole Abandoned

Date

NOV 7 1945

19

S. J. LEWIS Scout

Kansas Pool Name Silica**KANSAS**Map No. 1-49 Sec. 10 Twp. 20 R. 9WWell No. 2 Keesling "A"C. U. Bay Company**COMPLETED**

Contractor

SE NW SW

E11704
SECTION PLAT990 Ft. from N. Line

Ft. from S. Line

Ft. from E. Line

990 Ft. from W. Line

Rice County

Location

Rig up

Drilling and Remarks:

Cr 3219
5" 3221
500 rods
Pump 30 ft

*42 1/2***RECORD**

Cased _____ in., _____ ft.

Sand _____

Gas _____

Oil _____

Total Depth 32.34**PRODUCTION**

1st 24 hrs. Nat. _____

1st 24 hrs. after shot _____

Gas _____ Cu. Ft.

Dry Hole _____

Abandoned _____

Date

DEC 2 8 1945 19

S. J. LEWIS

Scout