

KANSAS

FORM 51 5M 4-41 PETROL

Rice

Section 10 Township 20 Range 9-W

Well No. #2 ~~#4~~ Keesling "B" ~~"A"~~

Company Colorado Petroleum

Keesling Pool

NORTH

WEST

EAST

0							

SOUTH

KANSAS

Rice

Sec. 10 Twp. 20 R. 9-WWell No. #4 Keesling #2-B Farm


Colorado Petr.

Company

(Keesling)

 Ft. from N. Line660 Ft. from S. Line Ft. from E. Line330 Ft. from W. Line

Elev. 1710

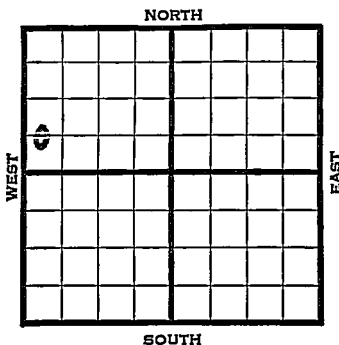

1941

REPORT

5/21

Derrick.

5/28

8" - 215' Drlg. 300'

6/5

Drlg. 2725'

6/11

Arb. 3257'

T.D. 3270'

Water.

ABANDONED

Map No. 49 Sec. 10 Twp. 20 R. 9WWell No. 4 Keesling "A"

Colorado Petroleum Company

FIRST REPORT Contractor

SECTION PLAT

C W L SW NW

Ft. from N. Line

660 Ft. from S. Line

Ft. from E. Line

330 Ft. from W. Line

0			

KEESLING POOL

Location _____

Rig up _____

Drilling and Remarks:

Derrick

RECORD

Cased _____ in., _____ ft.

Sand _____

Gas _____

Oil _____

Total Depth _____

PRODUCTION

1st 24 hrs. Nat. _____

1st 24 hrs. after shot _____

Gas _____ Cu. Ft.

Dry Hole _____

Abandoned _____

Date

MAY 21 1941 19

S. J. LEWIS Scout

Map No. 49 Sec. 10 Twp. 20 R. 9WWell No. 2 Keesling "B"Colorado Petroleum CompanyCORRECTION Contractor

SECTION PLAT

C W L SW NW

 Ft. from N. Line660 Ft. from S. Line Ft. from E. Line330 Ft. from W. Line

	<i>A Lease</i>		
	<i>B Lease</i>		

KEESLING POOL

Location Rig up Drilling and Remarks: Reported as

#4 Keesling "A"

RECORD

Cased ft.Sand Gas Oil Total Depth

PRODUCTION

1st 24 hrs. Nat. 1st 24 hrs. after shot Gas Cu. Ft.Dry Hole Abandoned

Date

JUN 4 1941S. J. LEWIS

Scout

Map No. 49 Sec. 10 Twp. 20 R. 9WWell No. 2 Keesling "B"Colorado Petroleum CompanyABANDONED Contractor

SECTION PLAT

C W L SW NW

 Ft. from N. Line660 Ft. from S. Line Ft. from E. Line330 Ft. from W. Line

o			

KEESLING POOL

Location Rig up

Drilling and Remarks:

*Cr X 3257**Water*

RECORD

Cased in., ft.Sand Gas Oil Total Depth 3270

PRODUCTION

1st 24 hrs. Nat. 1st 24 hrs. after shot Gas Cu. Ft.Dry Hole Abandoned

Date

JUN 11 1941 19

S. J. LEWIS Scout