


KANSAS Rice

FORM 51 5M 4-41 PETROL

Section 10 Township 20 Range 9-W

Well No. 3 Keesling

Company Colorado Petroleum

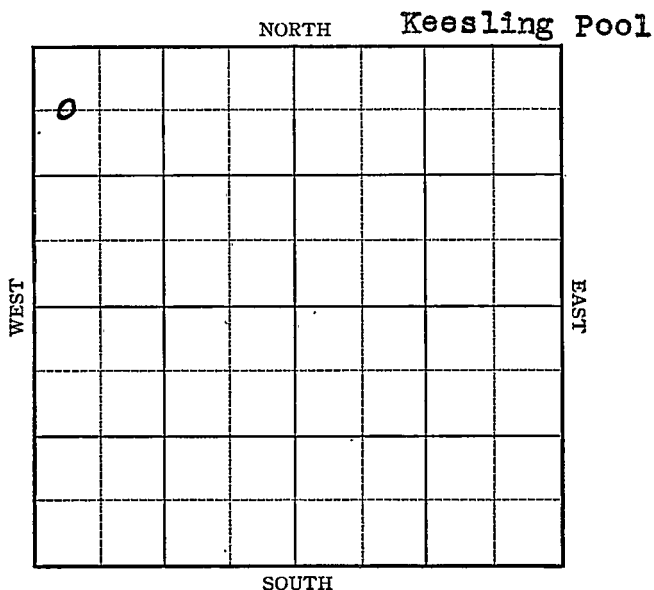

Sec. 10 Twp. 20 R. 9-W

Well No. #3 Keesling Farm

Colorado Petr. _____ Company

(Keesling)


660 Ft. from N. Line

Ft. from S. Line

Ft. from E. Line

330 Ft. from W. Line

Elev. 1701

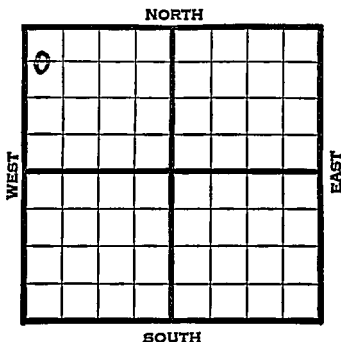[illegible]

Map No. 49 Sec. 10 Twp. 20 R. 9WWell No. 3 Keesling

Colorado Petroleum Company

Contractor

FIRST REPORT

C W L NW NW

SECTION PLAT

0			

660 Ft. from N. Line Ft. from S. Line Ft. from E. Line330 Ft. from W. Line

KEESLING POOL

Location Rig up

Drilling and Remarks:

Derrick

RECORD

Cased in., ft.Sand Gas Oil Total Depth

PRODUCTION

1st 24 hrs. Nat. 1st 24 hrs. after shot Gas Cu. Ft.Dry Hole Abandoned

Date

MAY 7 1941S. J. LEWISScout

Map No. 49 Sec. 10 Twp. 20 R. 9WWell No. 3 KeeslingColorado Petroleum CompanyCOMPLETED

Contractor

SECTION PLAT

C W L NW NW

0			

660 Ft. from N. Line Ft. from S. Line Ft. from E. Line330 Ft. from W. Line

KEESLING POOL

Location Rig up

Drilling and Remarks:

See 83208.5" @ 3208.2000 acidPump 657 BX

RECORD

Cased in., ft.Sand Gas Oil Total Depth 3223

PRODUCTION

1st 24 hrs. Nat. 1st 24 hrs. after shot Gas Cu. Ft.Dry Hole Abandoned

Date

JUN 4 1941 19S. J. LEWIS

Scout