

KANSAS


Rice

FORM 51 5M 4-41 PETROL

Section 10 Township 20 Range 9-W

Well No. #3 Keesling "B"


Company Colorado Petr.

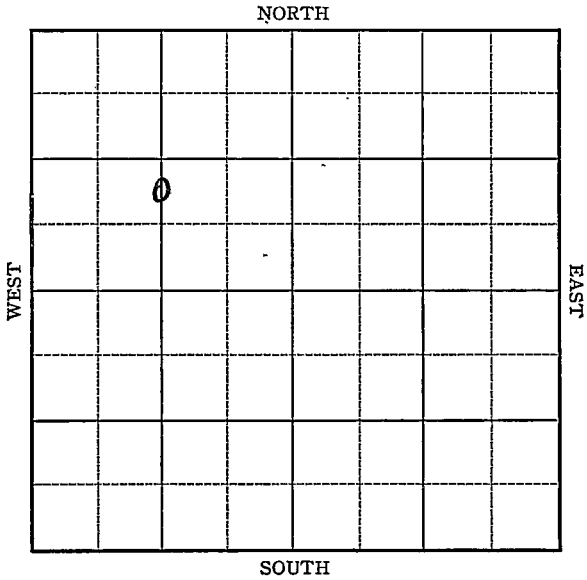

(Keesling)

Ft. from W. Line

Elev. 1691

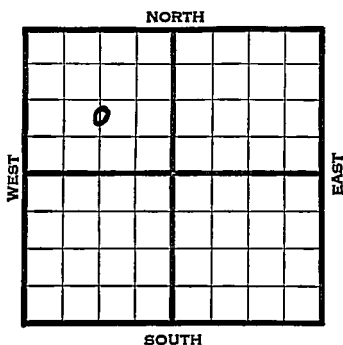

1941	REPORT
9/24	Location
10/2	"
10/9	Surface hole.
10/16	8" - 200' Drlg. 2545'
10/23	Arb. 3218-22' T.D. 5" - 3220'
	RUST.
10/30	T.D. 3230' 2000 acid.
	2400' water, S.O. in 1 hour.
11/5	Arb. 3218'
	5" - 3220'
	T.D. 3230'
	2000 acid.
	Pump 45 oil & 36 5 water.
	43.8 Gravity
	ABANDONED

Rice

KANSASMap No. K-49 Sec. 10 Twp. 20 R. 9WWell No. 3 Keesling "B"Colorado Petroleum Company**FIRST REPORT**

Contractor

C NL S $\frac{1}{2}$ NW**SECTION PLAT**

	o		

 Ft. from N. Line990 Ft. from S. Line1320 Ft. from E. Line Ft. from W. Line**KEESLING POOL**Location Rig up Drilling and Remarks: **RECORD**Cased in., ft.Sand Gas Oil Total Depth **PRODUCTION**1st 24 hrs. Nat. 1st 24 hrs. after shot Gas Cu. Ft.Dry Hole Abandoned

Date

SEP 24 1941 19 S. J. LEWIS Scout

Map No. K-49 Sec. 10 Twp. 20 R. 9WWell No. 3 Keesling "B"Colorado Petroleum CompanyCOMPLETED ContractorC NL S $\frac{1}{2}$ NW Ft. from N. Line990 Ft. from S. Line1320 Ft. from E. Line Ft. from W. Line

SECTION PLAT

KEESLING POOL

RECORD

Location Cased in., ft.Rig up Sand

Drilling and Remarks:

Gas Oil Total Depth 3230

PRODUCTION

1st 24 hrs. Nat. 1st 24 hrs. after shot Gas Cu. Ft.Dry Hole Abandoned

Date

NOV 5 1941 19

S. J. LEWIS Scout