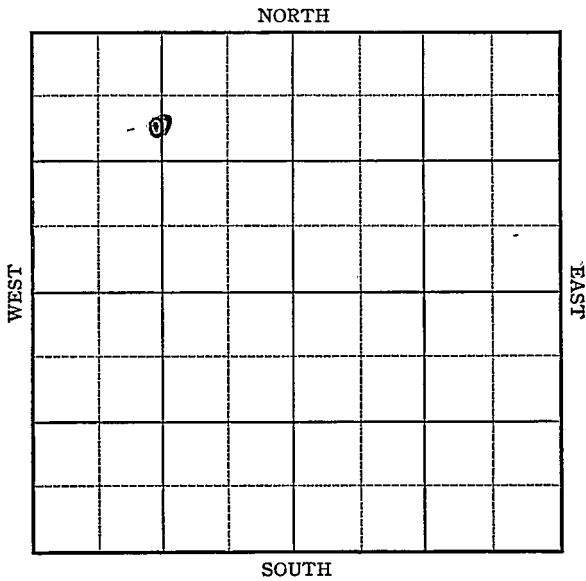


KANSAS

FORM 51, 5M 4-41 PETROL

Section 10 Township 20 Range 9WWell No. #4 Keesling "B" "A"Company Colorado Petroleum

KANSAS


Rice

Sec. 10 Twp. 20 R. 9-WWell No. #4 Keesling "B" "A" FarmColorado Petr. Company

(Keesling)

990 Ft. from N. Line Ft. from S. Line Ft. from E. Line1320 Ft. from W. Line

Elev. 1696

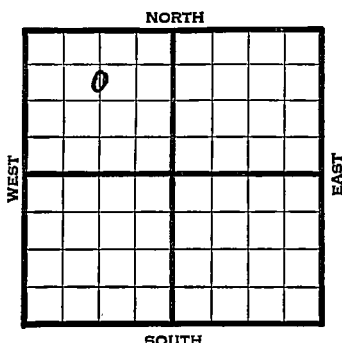

1941

REPORT

9/3

Cellar.

9/11

Rotary.

9/18

Surface hole.

9/25

8" - 209' Arb. 3216' T.D. 3219

5" - 3218' RUST.

10/2

" " "

10/8

Arb. 3216'

5" - 3218'

T.D. 3226'

2500 acid.


Potential 612 bbls., pump.

43.8 Gravity

COMPLETED

Map No. _____ Sec. 10 Twp. 20 R. 9WWell No. 4 Keesling "B"_____
Colorado Petroleum Company_____
FIRST REPORT ContractorC S L N $\frac{1}{2}$ NW990 Ft. from N. Line_____
Ft. from S. Line_____
Ft. from E. Line1320 Ft. from W. Line

SECTION PLAT

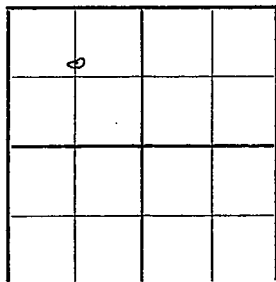

KEESLING POOL

Location _____

Rig up _____

Drilling and Remarks:

Cellar

RECORD

Cased _____ in., _____ ft.

Sand _____

Gas _____

Oil _____

Total Depth _____

PRODUCTION

1st 24 hrs. Nat. _____

1st 24 hrs. after shot _____

Gas _____ Cu. Ft.

Dry Hole _____

Abandoned _____

Date

SEP 3 1941 19S. J. LEWIS Scout

KANSASMap No. K-49 Sec. 10 Twp. 20 R. 9WWell No. 4 Keesling "A"Colorado Petroleum CompanyCORRECTION ContractorC SL N $\frac{1}{2}$ NW990 Ft. from N. Line Ft. from S. Line Ft. from E. Line1320 Ft. from W. Line**SECTION PLAT**

KEESLING POOLLocation Rig up

Drilling and Remarks:

Was reported as

#4 Keesling "B"

RECORDCased in., ft.Sand Gas Oil Total Depth **PRODUCTION**1st 24 hrs. Nat. 1st 24 hrs. after shot Gas Cu. Ft.Dry Hole Abandoned

Date

SEP 24 1941 19S. J. LEWIS Scout

Rice

KANSAS

Map No. K-49 Sec. 10 Twp. 20 R. 9WWell No. 4 Keesling "A"Colorado Petroleum CompanyCOMPLETED ContractorC SL N $\frac{1}{2}$ NW990 Ft. from N. Line Ft. from S. Line Ft. from E. Line1320 Ft. from W. Line

SECTION PLAT

KEESLING POOL

Location Rig up Drilling and Remarks: *Ar 8216**5" @ 3218**2500 acid**Pump 6/2 P.D.**435 Gr*

RECORD

Cased in., ft.Sand Gas Oil Total Depth 3226

PRODUCTION

1st 24 hrs. Nat. 1st 24 hrs. after shot Gas Cu. Ft.Dry Hole Abandoned

Date

OCT 8 1941 19 S. J. LEWIS Scout