

KANSAS

McPherson

Section 10 Township 20 Range 3-W

Well No. #1 Mugler


Company Westgate Greenland et al

Wildcat

NORTH

WEST

EAST

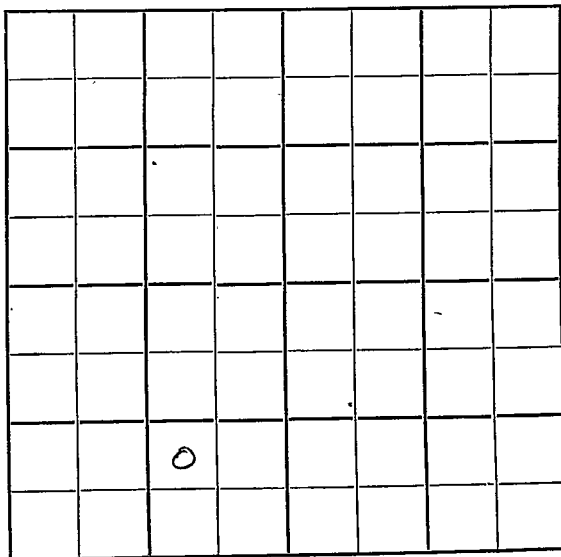

SOUTH

KANSAS

McPherson ✓

Sec. 10 Twp. 20 R. 3W

Well No. 1 Mugler Farm

Westgate Greenland et al Company

Mallard Contr.

Wildcat

Pool

NORTH


Ft. from N. Line

990 Ft. from S. Line

990 Ft. from E. Line

Ft. from W. Line

NW SE SW

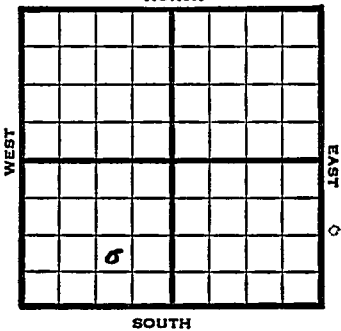

1949

Elev 1485'

REPORT

7/27

RUR

8/3

8" @ 171'

Dr1g 1744'

8/10

TD 3320'

Lans 2485'

Miss 3145'

Aband.

ABANDONED

Kansas

Wildcat

Map No. _____ Sec. 10 Twp. 20 R. 3W

Well No. 1 MuggleWestgate Greenland et al. CompanyMallard

Contractor

NW SE SW

FIRST REPORT
SECTION PLAT

_____ Ft. from N. Line

990 _____ Ft. from S. Line

990 _____ Ft. from E. Line

_____ Ft. from W. Line

McPherson County

Location _____

Rig up _____

Drilling and Remarks:

R U R

RECORD

Cased _____ in., _____ ft.

Sand _____

Gas _____

Oil _____

Total Depth _____

PRODUCTION

1st 24 hrs. Nat. _____

1st 24 hrs. after shot _____

Gas _____ Cu. Ft.

Dry Hole _____

Abandoned _____

Date

JUL 27 1949 19

S. J. LEWIS

Scout

Kansas


Map No. K43 Sec. 10 Twp. 20 R. 3WWell No. 1 MuglerWestgate-Greenland et al. Company**ABANDONED**

Contractor

NW SE SW

E11483
SECTION PLAT Ft. from N. Line990 Ft. from S. Line990 Ft. from E. Line Ft. from W. Line

McPherson County

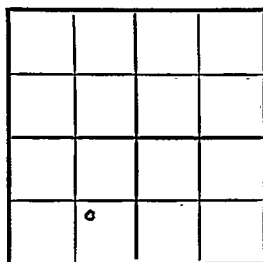

RECORD

Location Cased in., ft.Rig up Sand

Drilling and Remarks:

Gas Oil Total Depth 12320

PRODUCTION

1st 24 hrs. Nat. 1st 24 hrs. after shot Gas Cu. Ft.Dry Hole Abandoned

Date

AUG 10 1949 19S. J. LEWIS Scout