

Barton

KANSAS


SECTION 16 TOWNSHIP 20S RANGE 11W

WELL NO. #2 Hauser

COMPANY Morgenstern Oil Oper.

NORTH

N/2
~~NW~~ SW NW

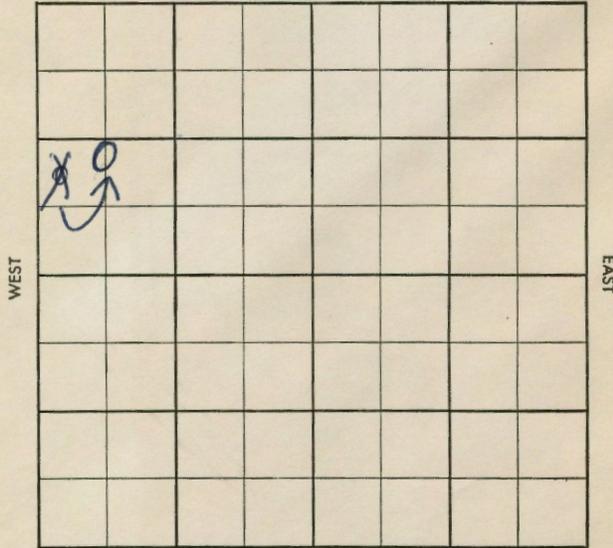

WEST

EAST

SOUTH

~~Twp~~ ~~Pool~~
~~Co.~~ ~~Facet~~
SURRECTION

8-513-B

County Barton Elev. 1772 DF
 Sec. 16 Twp. 20 Rge. 11W
 Company Morgenstern Oil Oper.
 Farm Name Hauser No. 2

TOPS	DEPTH	LOG	DATUM
Anh.			
Sp.	2640		
H.	2906		
Tr.	2922		
Dg.	2936		
B.L.	3032		
L.	3049		
K.C.			
B.K.C.			
Ce.			
C.			
M.			
M.			
K.			
Mz.			
Mq.			
V.			
S.			
S.			
A.	3287		
R.			
Pf.			
G.			
T.D.	3325		

Loc. in Sec. N² SW NW
1450 PNL
600 FWL
 Geol. _____
 Contr. Leben #3
 Pool Chase-Silica
ABANDONED
 JUL 23 '58

Date Comm. 7-10-58 8" 204/225
WORT JUL 15 '58 Ø 2000 JUL 23 '58 DST 3112-48
 1 hr 98 MW sgc scumoil BHP
 910/20" DST 3286-95 1 hr 680'
 Fld 9090w BHP 455/20"
 no log
D & A

~~Twp~~ ~~Pool~~
~~Co.~~ ~~Facet~~

S-513-B

County Barton Elev. _____
 Sec. 16 Twp. 20 Rge. 11W
 Company Morgenstern Oil Oper.
 Farm Name Hauser No. 2

TOPS	DEPTH	LOG	DATUM
Anh.			
Sp.			
H.			
Tr.			
Dg.			
B.L.			
L.			
K.C.			
B.K.C.			
Ce.			
C.			
M.			
M.			
K.			
Mz.			
Mq.			
V.			
S.			
S.			
A.			
R.			
Pf.			
G.			
T.D.			

Loc. in Sec. NW SW NW
 Geol. _____
 Contr. Leben #3
 Pool Chase-Silica
 JUL 9 '58
FIRST REPORT

Date Comm. _____
WORT

