


Map No. **KANSAS** Sec. 16 Twp. 20 R. 11WWell No. 3 Hansen Farm
Stanolind Oil & G Company

NORTH

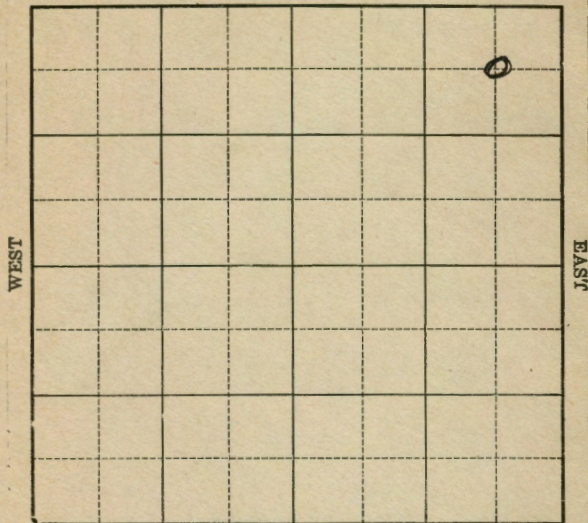

SOUTH

Location
Drilling RemarksRig Up
Drilling Remarks

RECORD

Cased _____ in. _____ ft.
 Sand _____
 Gas _____
 Oil _____
 Total Depth _____

PRODUCTION

1st 24 hrs. Nat. _____
 1st 24 hrs. after shot _____
 Gas _____ cu. ft.
 Dry Hole _____
 Abandoned _____

Map No. **KANSAS** Sec. 16 Twp. 20 R. 11WWell No. 3 Hansen Farm
Stanolind Oil & G Company


NORTH

660 Ft. from N. Line

Ft. from S. Line

660 Ft. from E. Line

Ft. from W. Line

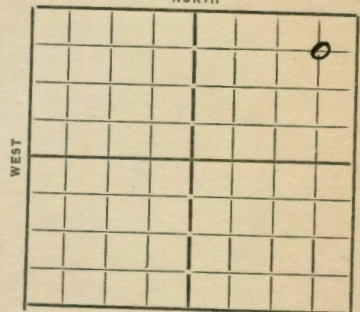

SOUTH

Date 1934

REPORT

4/25 Cellar
5/3 Rign up
5/10 Dlg 1060 12 1/2 218
5/18 " 2670
5/25 H.C.L. 3048 Siliceous 3288-91
 T D Run pipe
5/31 Rust
6/7 —
6/14 3299 T D sweet 25 Bbls per hr.
6/27 oil 3288 T D 3299 708 Bbls.

COMPLETED

Map No. 46 Sec. 16 Twp. 20 R. 11WWell No. 3-HansenStanolind O & G. Company

Contractor

COMPLETED

SECTION PLAT

			0

660 Ft. from N. Line

Ft. from S. Line

660 Ft. from E. Line

Ft. from W. Line

Location

Rig up

Drilling and Remarks:

RECORD

Cased in. ft.

Sand sil 3288

Gas

Oil

Total Depth 3299

PRODUCTION

1st 24 hrs. Nat.

1st 24 hrs. after shot

Gas Cu. Ft.

Dry Hole

Abandoned

708 bbls

Date

6-27-34 19 O. Mannschreck ScoutMap No. 46 Sec. 16 Twp. 20 R. 11WWell No. 3-HansenStanolind O & G. Company

Contractor

FIRST REPORTS

SECTION PLAT

			0

660 Ft. from N. Line

Ft. from S. Line

660 Ft. from E. Line

Ft. from W. Line

Location

Rig up

Drilling and Remarks:

RECORD

Cased in. ft.

Sand

Gas

Oil

Total Depth

PRODUCTION

1st 24 hrs. Nat.

1st 24 hrs. after shot

Gas Cu. Ft.

Dry Hole

Abandoned

Date

4-25-34 19 ORVAL MANNSCHRECK Scout