

O. W. P. B.


H. Carlson

Form 51-5M-11-31-Palace

Map No. KANSAS Sec. 16 Twp. 30 R. 11W

Well No. 2 Gerloff Farm _____
Stanolind Company

NORTH

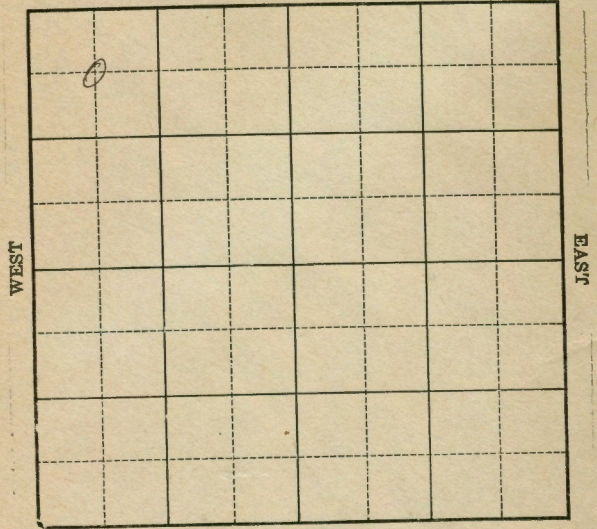

SOUTH

Location _____
Drilling Remarks _____

Rig Up _____
Drilling Remarks _____

RECORD

PRODUCTION

Cased _____ in. _____ ft.
Sand _____
Gas _____
Oil _____
Total Depth _____

1st 24 hrs. Nat. _____
1st 24 hrs. after shot _____
Gas _____ cu. ft. _____
Dry Hole _____
Abandoned _____

Form 25
5M 4-32 MPC


O. W. P. B.

H. Carlson

Map No. KANSAS Sec. 16 Twp. 20 R. 11W

Well No. 2 Gerloff Farm _____
Stanolind Company

NORTH

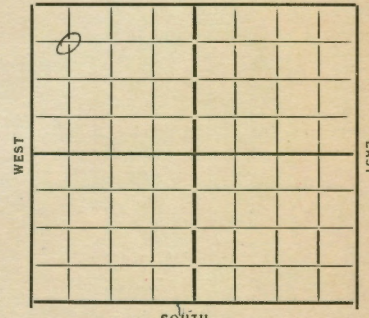

SOUTH

660' Ft. from N. Line

_____ Ft. from S. Line

_____ Ft. from E. Line

660 Ft. from W. Line

C NW NW

Date 1933 Elev. 1772' REPORT

- 12/13 Bldg Rig
- 12/27 Drdg 450
- 1/11 Top line 3055 - coring 3065
- 1/17 Silicious 3290
- Set 6" at 3289. RUST
- 1/24 T.D. 3318 - 150' oil 20 hrs.
- 1/31 -
- 2/7 Silicious 3290 TD 3318 189 Bbls.

COMPLETED

O. W. P. B.

1954
4/11

D&A
TD 3318'
KC 3252', Arb. 3289'
OTD 3318
6" @ 3289'
PB 3301, sdfrac, S/2-4 bopd 200 bw
PB 3264 32/3210-18, 44/3125-36,
2500A, 48/3210-18, 54/3125-36
P/tr oil 12 bw
D&A

FIRST REPORT

ABANDONED

Map No. 46 Sec. 16 Twp. 20 R. 11W

Well No. 2-Berloff

Standard Company

Contractor

COMPLETED

SECTION PLAT

660 Ft. from N. Line

..... Ft. from S. Line

..... Ft. from E. Line

660 Ft. from W. Line

0			

Location.....

Rig up.....

Drilling and Remarks:

189 lbs

RECORD

Cased..... in., ft.

Sand silicious 3290

Gas.....

Oil.....

Total Depth 3318

PRODUCTION

1st 24 hrs. Nat.....

1st 24 hrs. after shot.....

Gas..... Cu. Ft.

Dry Hole.....

Abandoned.....

Date

2-7-34 192 O. Mammuch Scout

Map No. 46 Sec. 16 Twp. 20 R. 11W

Well No. 2-Berloff

Standard Company

Contractor

FIRST REPORTS

SECTION PLAT

660 Ft. from N. Line

..... Ft. from S. Line

..... Ft. from E. Line

660 Ft. from W. Line

0			

Location.....

Rig up.....

Drilling and Remarks:

B.R.

RECORD

Cased..... in., ft.

Sand.....

Gas.....

Oil.....

Total Depth.....

PRODUCTION

1st 24 hrs. Nat.....

1st 24 hrs. after shot.....

Gas..... Cu. Ft.

Dry Hole.....

Abandoned.....

Date

12-13-33 192 O. Mammuch Scout