


Map No. _____ Sec. 16 Twp. 20 R. 11W
 Well No. 2-Hanser Farm _____
Stanolind Company

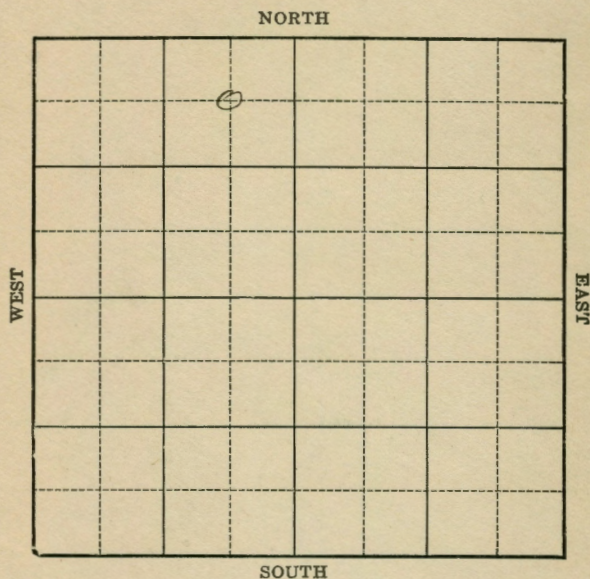


Location
Drilling Remarks

Rig Up
Drilling Remarks

RECORD
 Cased _____ in. _____ ft.
 Sand _____
 Gas _____
 Oil _____
 Total Depth _____

PRODUCTION
 1st 24 hrs. Nat. _____
 1st 24 hrs. after shot _____
 Gas _____ cu. ft.
 Dry Hole _____
 Abandoned _____

Map No. _____ Sec. 16 Twp. 20 R. 11-W
 Well No. 2-Hanser Farm _____
Stanolind Company

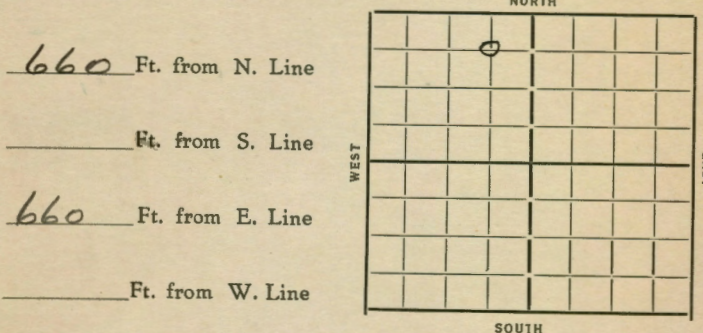

660 Ft. from N. Line
 _____ Ft. from S. Line
660 Ft. from E. Line
 _____ Ft. from W. Line

Date
1933

REPORT

6/28 Location
7/5 Pond
7/12 _____
7/19 _____
7/26 Rig
8/2 Bldg Rig
8/19 Rig
8/17 _____
8/23 _____
8/30 _____
9/6 _____
9/13 _____
9/20 Moving in tools 9/29 _____
10/5 _____
10/11 Rig
10/18 12" at 207 - Drilg 1881
10/25 Drilg 7880
11/1 Sil 3280 - 7" at 3275 RUST.
11/8 T.D. 3292 - 2000' oil - C.O.
11/15 " 3298 - pump 18 bbls per hr
11/22 Silicious 3280-3292
 334 bbls

COMPLETED

Map No. 46 Sec. 16 Twp. 20 R. 11WWell No. 2-HauserStanolind Company

Contractor

COMPLETED

SECTION PLAT

660 Ft. from N. Line

Ft. from S. Line

660 Ft. from E. Line

Ft. from W. Line

	0		

Location.....

Rig up.....

Drilling and Remarks:

RECORD

Cased.....in.,.....ft.

Sand silts 3280

Gas.....

Oil.....

Total Depth 3292

PRODUCTION

1st 24 hrs. Nat.....

1st 24 hrs. after shot.....

Gas.....Cu. Ft.

Dry Hole.....

Abandoned.....

Date

11-22-33 192. O. Mannick ScoutMap No. 46 Sec. 16 Twp. 20 R. 11WWell No. 2-HauserStanolind Company

Contractor

CNE NW

SECTION PLAT

660 Ft. from N. Line

Ft. from S. Line

660 Ft. from E. Line

Ft. from W. Line

	0		

FIRST REPORTS

Location.....

Rig up.....

Drilling and Remarks:

RECORD

Cased.....in.,.....ft.

Sand.....

Gas.....

Oil.....

Total Depth.....

PRODUCTION

1st 24 hrs. Nat.....

1st 24 hrs. after shot.....

Gas.....Cu. Ft.

Dry Hole.....

Abandoned.....

Date

6/28/33 192. O. Mannick Scout