


Map No. **KANSAS** Sec. 16 Twp. 20 R. 11W  
Well No. 5 Hansen Farm  
Standard Oil Co Company

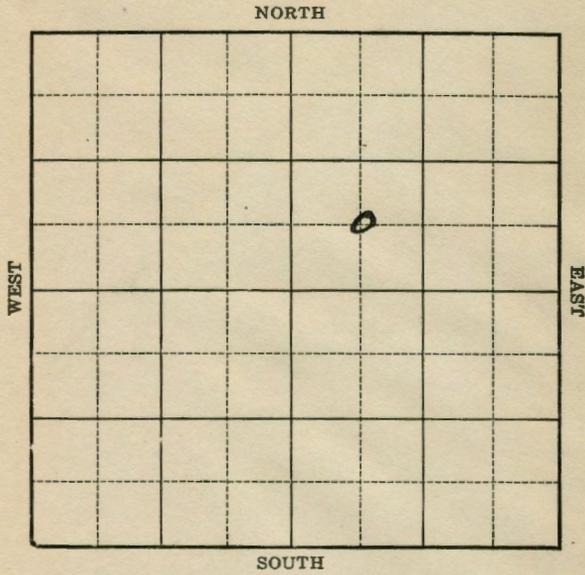

Location \_\_\_\_\_  
Drilling Remarks \_\_\_\_\_

Rig Up \_\_\_\_\_  
Drilling Remarks \_\_\_\_\_

RECORD


Cased \_\_\_\_\_ in. \_\_\_\_\_ ft.  
Sand \_\_\_\_\_  
Gas \_\_\_\_\_  
Oil \_\_\_\_\_  
Total Depth \_\_\_\_\_

PRODUCTION

1st 24 hrs. Nat. \_\_\_\_\_  
1st 24 hrs. after shot \_\_\_\_\_  
Gas \_\_\_\_\_ cu. ft. \_\_\_\_\_  
Dry Hole \_\_\_\_\_  
Abandoned \_\_\_\_\_

Map No. **KANSAS** Sec. 16 Twp. 20 R. 11W  
Well No. 5 Hansen Farm  
Standard Oil Co Company

\_\_\_\_\_ Ft. from N. Line  
660 Ft. from S. Line  
\_\_\_\_\_ Ft. from E. Line  
660 Ft. from W. Line

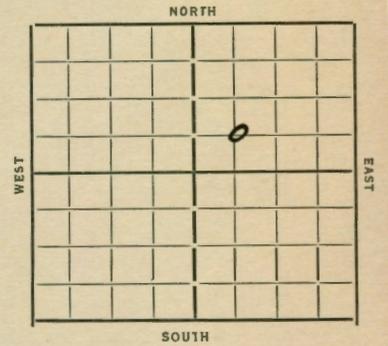

Date 1934

REPORT

10/10 Location  
10/18 Moving in  
10/25 Bldg. Rig  
11/1 Rig  
11/8 dly 1350  
11/15 " 2445  
11/22 K.C. 3052 Coring 3122  
11/28 5" 3286 Siliceous 3288  
Rust  
12/6 \_\_\_\_\_ 12/13 \_\_\_\_\_  
12/21 TD 3293 1300' oil  
12/27 \_\_\_\_\_  
1/3/35 Rgn to pump  
1/10 \_\_\_\_\_ 1/17 \_\_\_\_\_  
1/23 Siliceous 3288 TD 3293  
436 bbls.

COMPLETED

Map No. 46 Sec. 16 Twp. 20 R. 11W  
Well No. 5-Hansen  
Stanolind Oil Co. Company  
Contractor

COMPLETED SECTION PLAT

Ft. from N. Line  
660 Ft. from S. Line  
Ft. from E. Line  
660 Ft. from W. Line

		0	

Location  
Rig up  
Drilling and Remarks:

436 bbls

RECORD  
Cased \_\_\_\_\_ in., \_\_\_\_\_ ft.  
Sand siliceous 3288  
Gas \_\_\_\_\_  
Oil \_\_\_\_\_  
Total Depth 3293

PRODUCTION  
1st 24 hrs. Nat. \_\_\_\_\_  
1st 24 hrs. after shot \_\_\_\_\_  
Gas \_\_\_\_\_ Cu. Ft.  
Dry Hole \_\_\_\_\_  
Abandoned \_\_\_\_\_

Date 1-23-35 1935 ORVAL MANNSCHECK Scout

Map No. 46 Sec. 16 Twp. 20 R. 11W  
Well No. 5-Hansen  
Stanolind Oil Co. Company  
Contractor

FIRST REPORTS SECTION PLAT

Ft. from N. Line  
660 Ft. from S. Line  
Ft. from E. Line  
660 Ft. from W. Line

		0	

Location   
Rig up  
Drilling and Remarks:

RECORD  
Cased \_\_\_\_\_ in., \_\_\_\_\_ ft.  
Sand \_\_\_\_\_  
Gas \_\_\_\_\_  
Oil \_\_\_\_\_  
Total Depth \_\_\_\_\_

PRODUCTION  
1st 24 hrs. Nat. \_\_\_\_\_  
1st 24 hrs. after shot \_\_\_\_\_  
Gas \_\_\_\_\_ Cu. Ft.  
Dry Hole \_\_\_\_\_  
Abandoned \_\_\_\_\_

Date 10-10-37 1937 ORVAL MANNSCHECK Scout