

KANSAS


Barton

Form 51-5M-7-39-Palace

Section 16 Township 20 Range 11-WWell No. #6 HauserCompany Stanolind

Silica Pool

NORTH

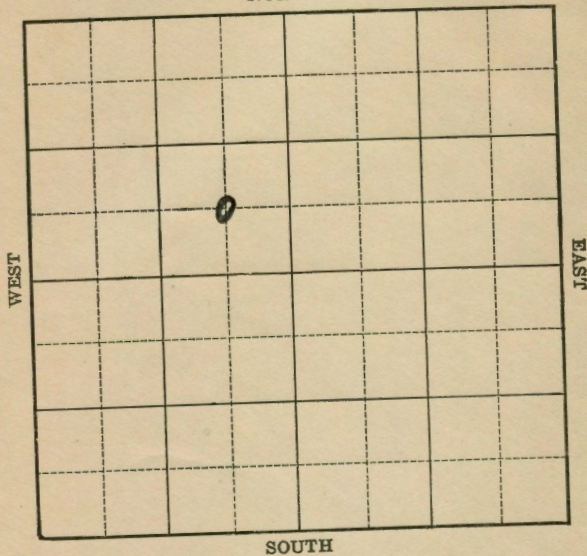

SOUTH

FORM 252-A 5M 2-40

KANSAS

Barton

Sec. 16 Twp. 20 R. 11-WWell No. #6 Hauser Farm

Stanolind Company


(Silica)

Ft. from N. Line

660 Ft. from S. Line660 Ft. from E. Line

Ft. from W. Line

Elev. 1771

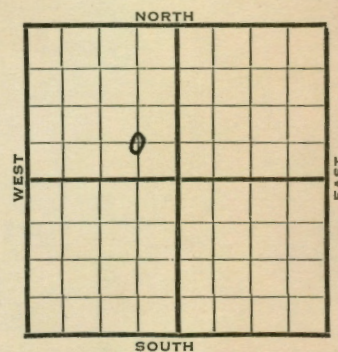

1940	REPORT
<u>3/27</u>	Location
<u>4/4</u>	10" - 212' WOC.
<u>4/12</u>	Anhy 485' Drlg. 2030'
<u>4/18</u>	Arb. 3288-93' T.D. Run 5".
<u>4/25</u>	T.D. 3295' 1000 acid.
	Testing.
<u>5/2</u>	T.D. 3295' Temp. potential 600 bbls.
<u>5/9</u>	" " " "
<u>5/16</u>	" " " "
<u>5/23</u>	" " " "
<u>5/29</u>	" " " "
<u>6/6</u>	" " " "
<u>6/12</u>	Arb. 3288'
	5" - 3289'
	T.D. 3295'
	1000 acid.
	15 bbls.
	COMPLETED

Barton

KANSAS

Map No. 49 Sec. 16 Twp. 20 R. 11WWell No. 6 Hauser

Stanolind

Company

Contractor

COMPLETED

C SE NW

Ft. from N. Line

660 Ft. from S. Line660 Ft. from E. Line

Ft. from W. Line

SECTION PLAT

SILICA POOL

Location

RECORD

Cased in., ft.

Sand

Gas

Oil

Total Depth 3295

PRODUCTION

1st 24 hrs. Nat.

1st 24 hrs. after shot

Gas Cu. Ft.

Dry Hole

Abandoned

Rig up

Drilling and Remarks:

At 32885" @ 32891000 acid15 x 1/2

Date

JUN 12 1940 19S. J. LEWIS Scout

Barton KANSAS

Map No. 46 Sec. 16 Twp. 20 R. 11WWell No. 6 Hauser

Stanolind

Company

Contractor

FIRST REPORT

SECTION PLAT

C SE NW

Ft. from N. Line

660 Ft. from S. Line660 Ft. from E. Line

Ft. from W. Line

SILICA POOL

Location X

RECORD

Cased in., ft.

Sand

Gas

Oil

Total Depth

PRODUCTION

1st 24 hrs. Nat.

1st 24 hrs. after shot

Gas Cu. Ft.

Dry Hole

Abandoned

Date

MAR 27 1940 19S. J. LEWIS Scout