


KANSAS

Form 51-5M-7-40-Palace

Barton

Section 18 Township 20 Range 11-WWell No. #3 KowalskyCompany Hollow et al

NORTH Clawson Pool

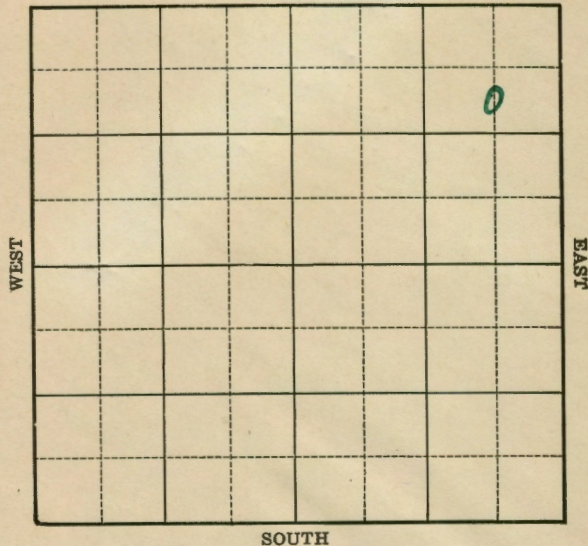


FORM 282-A 5M 7-40 PETROL

KANSAS

Barton

Sec. 18 Twp. 20 R. 11WWell No. 3 Kowalsky FarmHollow et al Company
(Clawson Pool)990 Ft. from N. Line Ft. from S. Line660 Ft. from E. Line Ft. from W. Line

Elev. 1780

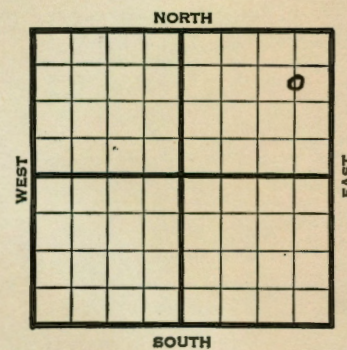

1940	REPORT
8/28	8" 228 Anhy. 535
	Dlg. 800
9/5	Drlg. 3050'
9/12	Arb. 3294' 5" - 3294' TD 3300'
	Swab 12 bbls. 1 hour.
	1000 acid.
9/18	Arb. 3294'
	5" - 3294'
	T.D. 3300'
	1000 acid.
	Echometer potential 3273 bbls.
	Maximum 3000 bbls.
	COMPLETED

Map No. 46 Sec. 18 Twp. 20 R. 11WWell No. 3 KowalskyHollow etal

Company

Contractor

COMPLETED

SECTION PLAT

C S L NE NE

990 Ft. from N. Line

Ft. from S. Line

600 Ft. from E. Line

Ft. from W. Line

CLAWSON POOL

Location

RECORD

Cased in., ft.

Sand

Gas

Oil

Total Depth 3300

PRODUCTION

1st 24 hrs. Nat.

1st 24 hrs. after shot

Gas Cu. Ft.

Dry Hole

Abandoned

Date

SEP 18 1940

S. J. LEWIS Scout

Map No. 46 Sec. 18 Twp. 20 R. 11WWell No. 3 KowalskyHollow etal

Company

Contractor

FIRST REPORT

SECTION PLAT

C S L NE NE

990 Ft. from N. Line

Ft. from S. Line

660 Ft. from E. Line

Ft. from W. Line

CLAWSON POOL

Location

RECORD

Cased in., ft.

Sand

Gas

Oil

Total Depth

PRODUCTION

1st 24 hrs. Nat.

1st 24 hrs. after shot

Gas Cu. Ft.

Dry Hole

Abandoned

Date

AUG 28 1940

S. J. LEWIS Scout