



Section 18 Township 20 Range 11-W
 Well No. 4 Kowalsky
 Company Shell

NORTH Silica Pool

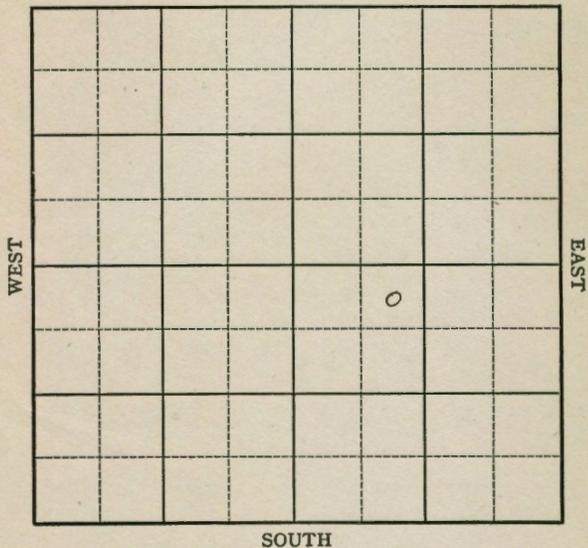

Sec. 18 Twp. 20 R. 11-W
 Well No. #4 Kowalsky Farm _____
 (silica) Shell Company _____

330 Ft. from N. Line
 _____ Ft. from S. Line
 _____ Ft. from E. Line
990 Ft. from W. Line

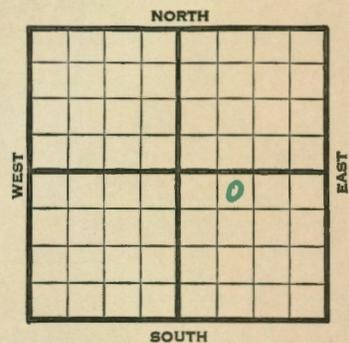

Elev. 1786

1941	REPORT
7/23	Location
7/31	Spud 145'
8/7	8" @ 238' Drlg. 2666'
8/15	Topeka 2862 Lansing 3070 Arb. 3292-94 T.D. 3294 4" 3293
8/21	Drlg. 3314'
8/28	T.D. 3333' 1000 acid. Swab 34 oil in 4 hours.
9/4	" " " "
9/10	Arb. 3272' 4" - 3293' T.D. 3333' 7000 acid. Potential 189 bbls., pump. 45. Gravity
	COMPLETED

Map No. _____ Sec. 18 Twp. 20 R. 11W

Well No. 4 Kowalsky

Shell Company

COMPLETED Contractor

NE NW SE

330 Ft. from N. Line

_____ Ft. from S. Line

_____ Ft. from E. Line

990 Ft. from W. Line

SECTION PLAT

		o	

SILICA POOL

Location _____

Rig up _____

Drilling and Remarks:

Core 3272.

4" @ 3293

7000 cu ft

Pump 189 Pt

45° Gr.

RECORD

Cased _____ in., _____ ft.

Sand _____

Gas _____

Oil _____

Total Depth *3333*

PRODUCTION

1st 24 hrs. Nat. _____

1st 24 hrs. after shot _____

Gas _____ Cu. Ft.

Dry Hole _____

Abandoned _____

Date

SEP 10 1941 19

S. J. LEWIS Scout

Map No. _____ Sec. 18 Twp. 20 R. 11W

Well No. 4 Kowalsky

Shell Company

FIRST REPORT Contractor

NE NW SE

330 Ft. from N. Line

_____ Ft. from S. Line

_____ Ft. from E. Line

990 Ft. from W. Line

SECTION PLAT

		o	

SILICA POOL

Location *X* _____

Rig up _____

Drilling and Remarks:

RECORD

Cased _____ in., _____ ft.

Sand _____

Gas _____

Oil _____

Total Depth _____

PRODUCTION

1st 24 hrs. Nat. _____

1st 24 hrs. after shot _____

Gas _____ Cu. Ft.

Dry Hole _____

Abandoned _____

Date

JUL 23 1941 19

S. J. LEWIS Scout