


Section 18 Township 20 Range 11-W
 Well No. #5 Kowalsky
 Company Hollow et al


NORTH Silica Pool

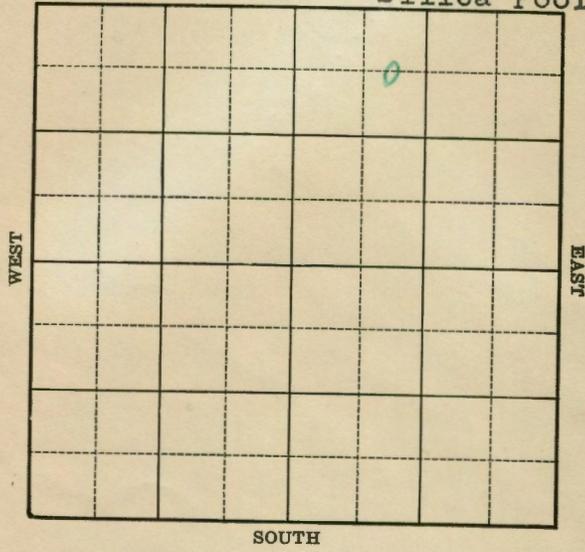

Sec. 18 Twp. 20 R. 11-W
 Well No. #5 Kowalsky Farm
Hollow et al Company

(Silica)

660 Ft. from N. Line
 _____ Ft. from S. Line
 _____ Ft. from E. Line
990 Ft. from W. Line

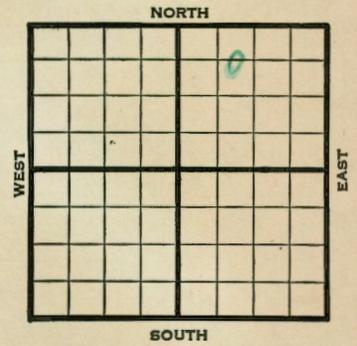

Elev. 1782

1940	REPORT
10/30	Location
11/7	Derrick.
11/14	8" - 234' WOC.
11/29	Lans. 3075' Drlg. 3204'
11/27	Arb. 3304' 5" - 3305'
	T.D. 3310½' Swab 16 bbls. per hour 2 hours.
12/4	Arb. 3304'
	5" - 3305'
	T.D. 3310½'
	Echometer potential 4280 bbls. Maximum 3000 bbls.
	36.7 Gravity
	COMPLETED

Map No. 46 Sec. 18 Twp. 20 R. 11W

Well No. 5 Kowalsky

Hollow etal Company

Contractor

COMPLETED

SECTION PLAT

C E L NW NE

660 Ft. from N. Line

_____ Ft. from S. Line

_____ Ft. from E. Line

990 Ft. from W. Line

		o	

SILICA POOL

Location _____

RECORD

Cased _____ in., _____ ft.

Rig up _____ Sand _____

Drilling and Remarks: Gas _____

Oil _____

Total Depth 3310 1/2

PRODUCTION

1st 24 hrs. Nat. _____

1st 24 hrs. after shot _____

Gas _____ Cu. Ft.

Dry Hole _____

Abandoned _____

Date _____

DEC 4 1940

19

S. J. LEWIS Scout

Map No. 46 Sec. 18 Twp. 20 R. 11W

Well No. 5 Kowalsky

Hollow etal Company

Contractor

FIRST REPORT

SECTION PLAT

C E L NW NE

660 Ft. from N. Line

_____ Ft. from S. Line

_____ Ft. from E. Line

990 Ft. from W. Line

		o	

SILICA POOL

Location **X** _____

RECORD

Cased _____ in., _____ ft.

Rig up _____ Sand _____

Drilling and Remarks: Gas _____

Oil _____

Total Depth _____

PRODUCTION

1st 24 hrs. Nat. _____

1st 24 hrs. after shot _____

Gas _____ Cu. Ft.

Dry Hole _____

Abandoned _____

Date _____

OCT 30 1940

19

S. J. LEWIS Scout