

Sec. 18 Twp. 20 R. 11-W

Well No. #2 Kowalsky Farm _____

Hollow et al Company _____

(Silica)


_____ Ft. from N. Line

990 Ft. from S. Line

_____ Ft. from E. Line

660 Ft. from W. Line

Elev. 1778

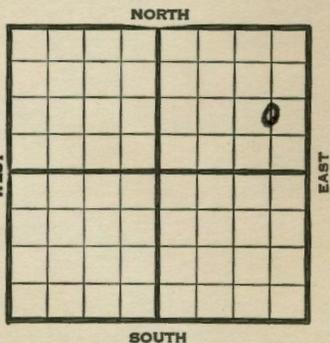


1940	REPORT
5/8	Bldg. rotary derrick.
5/16	8" - 164' Anhy 530' Drlg. 1515'
5/23	Drlg. 2105'
5/29	Lansing 3065' Drlg. 3106'
6/6	Lans. 3065' Arb. 3287' 5" - 3287' T.D. 3300' 2000 acid. Pump 108 bbls. 10 hours.
6/13	Testing.
6/19	Arb. 3287' 5" - 3287' T.D. 3300' 5000 acid. Echometer potential 2707 bbls.
	COMPLETED

Section 18 Township 20 Range 11-W

Well No. #2 Kowalsky

Company Hollow et al

NORTH **Silica Pool**

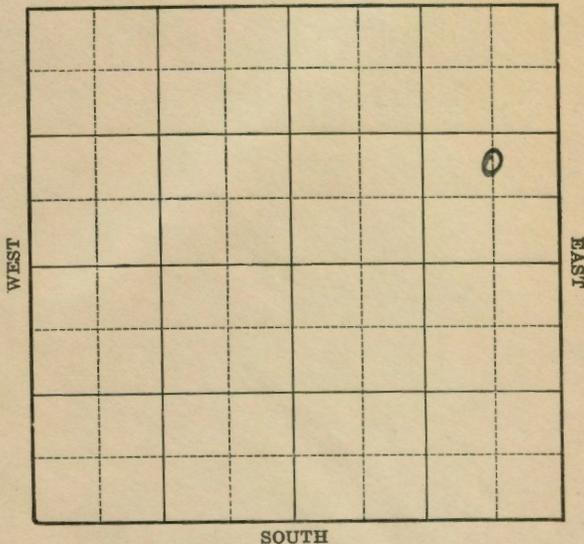

Map No. 46 Sec. 18 Twp. 20 R. 11W

Well No. 2 Kowalsky

Hollow etal Company

Contractor

COMPLETED

0 N $\frac{1}{2}$ SENE

Ft. from N. Line

990 Ft. from S. Line

Ft. from E. Line

660 Ft. from W. Line

SILICA POOL

SECTION PLAT

Location _____

Rig up _____

Drilling and Remarks:

*Ar 83287
5" @ 3287
5000 cu ft
Echometer R &
2707*

RECORD

Cased _____ in., _____ ft.

Sand _____

Gas _____

Oil _____

Total Depth 3300

PRODUCTION

1st 24 hrs. Nat. _____

1st 24 hrs. after shot _____

Gas _____ Cu. Ft.

Dry Hole _____

Abandoned _____

Date

JUN 19 1940 19

S. J. LEWIS Scout

Map No. 46 Sec. 18 Twp. 20 R. 11W

Well No. 2 Kowalsky

Hollow etal Company

Contractor

FIRST REPORT

SECTION PLAT

C N $\frac{1}{2}$ SE NE

Ft. from N. Line

990 Ft. from S. Line

Ft. from E. Line

660 Ft. from W. Line

SILICA POOL

Location _____

Rig up _____

Drilling and Remarks:

Bldg. Roty. Derrick

RECORD

Cased _____ in., _____ ft.

Sand _____

Gas _____

Oil _____

Total Depth _____

PRODUCTION

1st 24 hrs. Nat. _____

1st 24 hrs. after shot _____

Gas _____ Cu. Ft.

Dry Hole _____

Abandoned _____

Date

MAY 8 1940 19

S. J. LEWIS Scout