



Section 18 Township 20 Range 11-W  
 Well No. #2 Kowalsky  
 Company Shell

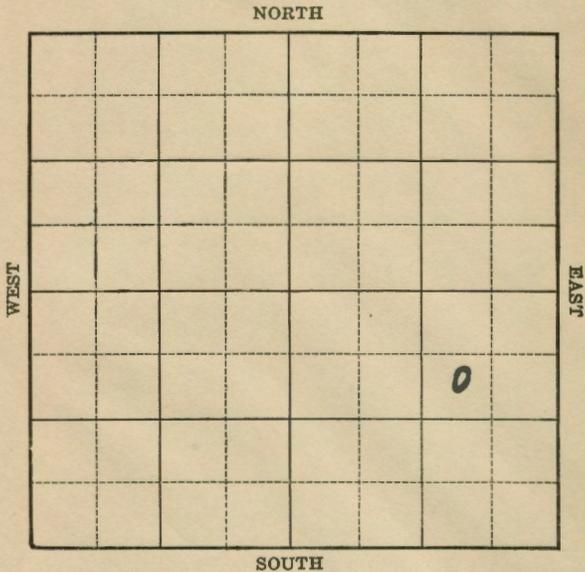

Sec. 18 Twp. 20 R. 11-W  
 Well No. #2 Kowalsky Farm \_\_\_\_\_  
Shell Company \_\_\_\_\_

(Silica)  
878 Ft. from N. Line  
 \_\_\_\_\_ Ft. from S. Line  
881 Ft. from E. Line  
 \_\_\_\_\_ Ft. from W. Line

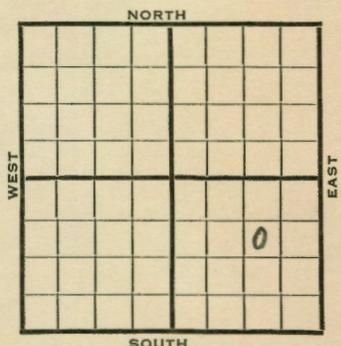

**Elev. 1785**

1940	REPORT
4/3	Location
4/12	"
4/18	"
4/25	Cellar.
5/2	8" - 258' Drlg. 1818'
5/9	Topeka 2680' Drlg. 3122'
5/16	Lansing 3059' Arb. 3281'
	T.D. 3291' Swab 170 bbls. oil 3 hours.
5/23	Pump 16 bbls. fluid in 4 hours.
5/29	Arb. 3281'
	4" - 3283'
	T.D. 3291'
	Depthograph potential 6440 bbls.
	Maximum 3000 bbls.
	<b>COMPLETED</b>

Map No. 49 Sec. 18 Twp. 20 R. 11W

Well No. 2 Kowalsky

Shell Company

Contractor

**COMPLETED**

**SECTION PLAT**

SW NE SE

878 Ft. from N. Line

Ft. from S. Line

881 Ft. from E. Line

Ft. from W. Line

			o

SILICA POOL

Location \_\_\_\_\_

Rig up \_\_\_\_\_

Drilling and Remarks:

*Ar # 3281*  
*4" C 3283*

*Depthograph Plot*  
*6440*

*Maximum 3000*

**RECORD**

Cased \_\_\_\_\_ in., \_\_\_\_\_ ft.

Sand \_\_\_\_\_

Gas \_\_\_\_\_

Oil \_\_\_\_\_

Total Depth 3291

**PRODUCTION**

1st 24 hrs. Nat. \_\_\_\_\_

1st 24 hrs. after shot \_\_\_\_\_

Gas \_\_\_\_\_ Cu. Ft.

Dry Hole \_\_\_\_\_

Abandoned \_\_\_\_\_

Date

MAY 29 1940 19

S. J. LEWIS Scout

Map No. 46 Sec. 18 Twp. 20 R. 11W

Well No. 2 Kowalsky

Shell Company

Contractor

**FIRST REPORT**

**SECTION PLAT**

SW NE SE

878 Ft. from N. Line

Ft. from S. Line

881 Ft. from E. Line

Ft. from W. Line

			o

SILICA POOL

Location X

Rig up \_\_\_\_\_

Drilling and Remarks:

**RECORD**

Cased \_\_\_\_\_ in., \_\_\_\_\_ ft.

Sand \_\_\_\_\_

Gas \_\_\_\_\_

Oil \_\_\_\_\_

Total Depth \_\_\_\_\_

**PRODUCTION**

1st 24 hrs. Nat. \_\_\_\_\_

1st 24 hrs. after shot \_\_\_\_\_

Gas \_\_\_\_\_ Cu. Ft.

Dry Hole \_\_\_\_\_

Abandoned \_\_\_\_\_

Date

APR 3 1940 19

S. J. LEWIS Scout