

Sec. 18 Twp. 20 R. 11-W

Well No. #1 Joe Kowalsky Farm

C.R.A.
Frank Hollow Company

(Clawson)


Ft. from N. Line

330 Ft. from S. Line

330 Ft. from E. Line

Ft. from W. Line
SE SE NE

Elev. 1779'

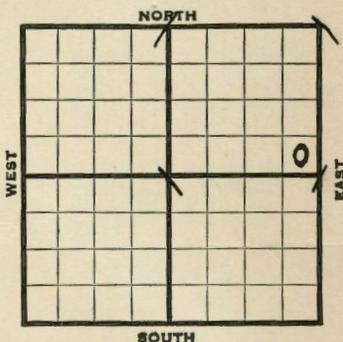

REPORT

1939	
3/15	B.R.R.
3/24	S. H.
3/31	8" - 173' Anhy 515' Drlg. 2024'
4/7	Topeka 2664' Lans. 3048' Drlg. 3157'
4/14	Arb. 3294-99' T.D. S.O. 5" - 3297' RUST.
4/19	5" - 3297' Arb. 3294' T. D. 3306' 2000 acid. Depthograph potential 4457 bbls. Maximum 3000 bbls.
COMPLETED	
1951 2/28	O.W.W.O. Arb. 3294 OTD 3306 5" @3297 DD 3325'


OVER

Section 18 Township 20 Range 11-W

Well No. 1 Joe Kowalsky

CRA
Frank Hollow Company

Clawson Pool

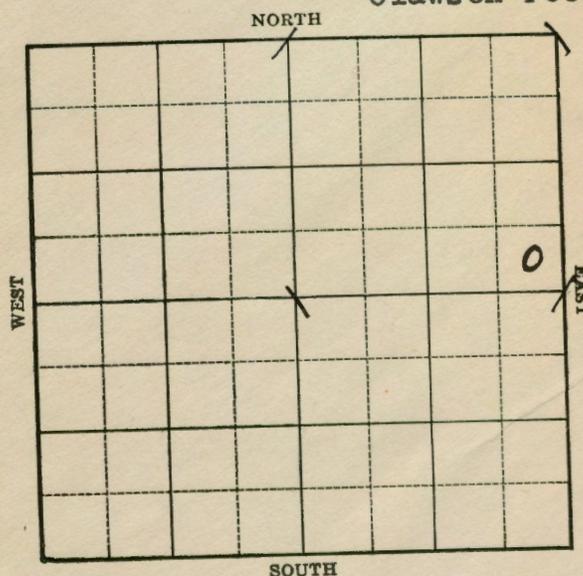

572762

1951

3/14

Oil well TD 3352

Arb. 3294, OTD 3306, 5" @ 3297,

DD 3330, 4" liner @ 3330

TD 3352

Comp. 8 bopd

COMPLETED

Map No. 46 Sec. 18 Twp. 20 R. 11W

Well No. 1 Joe Kowalsky

Frank Hollow Company

Contractor

COMPLETED

SECTION PLAT

SE NE

_____ Ft. from N. Line

330 Ft. from S. Line

330 Ft. from E. Line

_____ Ft. from W. Line

Clawson Pool

			0

Location _____

Rig up _____

Drilling and Remarks:

*2000 Acid
Depthograph Pot.
4457*

Maximum 3000 lbs

RECORD

Cased 5 in., 3297 ft.

Sand Arb 3294

Gas _____

Oil _____

Total Depth 3306

PRODUCTION

1st 24 hrs. Nat. _____

1st 24 hrs. after shot _____

Gas _____ Cu. Ft.

Dry Hole _____

Abandoned _____

Date

APR 19 1939 19

H. D. Hatfield Scout

Map No. 46 Sec. 18 Twp. 20 R. 11W

Well No. 1 Joe Kowalsky

Frank Hollow Company

Contractor

FIRST REPORT

SECTION PLAT

SE NE

_____ Ft. from N. Line

330 Ft. from S. Line

330 Ft. from E. Line

_____ Ft. from W. Line

CLAWSON POOL

			0

Location _____

Rig up _____

Drilling and Remarks:

BRR

RECORD

Cased _____ in., _____ ft.

Sand _____

Gas _____

Oil _____

Total Depth _____

PRODUCTION

1st 24 hrs. Nat. _____

1st 24 hrs. after shot _____

Gas _____ Cu. Ft.

Dry Hole _____

Abandoned _____

Date

MAR 15 1939 19

H. D. Hatfield Scout

