

Barton

KANSAS


FORM 252-A 5M 2-40

KANSAS

Barton

Section 18 Township 20 Range 11-WWell No. #3 SchartzCompany Gulf

NORTH Clawson Pool

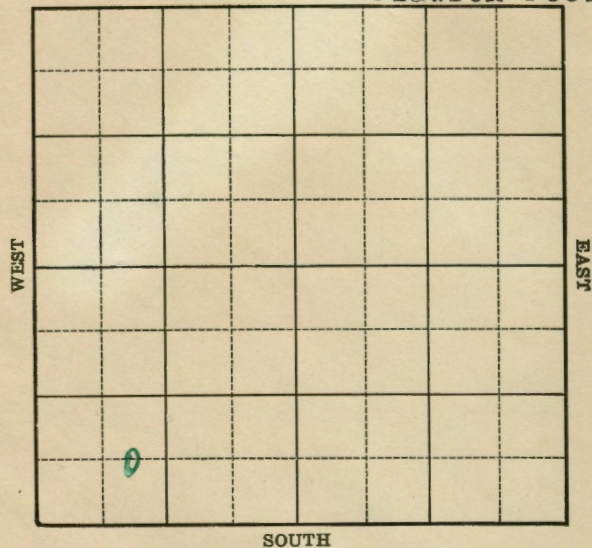Sec. 18 Twp. 20 R. 11-WWell No. #3 Schartz FarmGulf

Company

(Clawson)

Ft. from N. Line

660


Ft. from S. Line

Ft. from E. Line

990

Ft. from W. Line

Elev. 1791

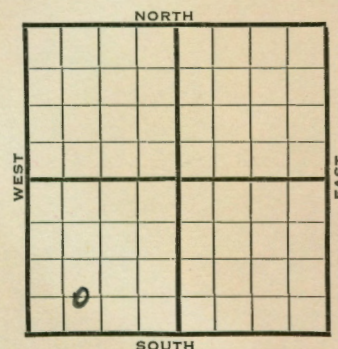

1940

REPORT

7/24

Derrick.

8/2

Drig. 2032'

8/8

Arb. 3290-91' T.D. 5" - 3291'
RUST.

8/14

3306 T.D. 2000 acid

Pump 135 bbls 10 hrs.

8/22

T.D. 3312' Flow 112 bbls. 11
hrs. 2½ M gas.

8/29

" " "

9/5

" " "

9/11

Arb. 3292'

5" - 3292½'

T.D. 3306'

2000 acid.

Sonimeter potential 3000 bbls.

COMPLETED

Map No. 46 Sec. 18 Twp. 20 R. 11WWell No. 3 SchartzGulf

Company

Contractor

COMPLETED

C E L SW SW

Ft. from N. Line

660 Ft. from S. Line

Ft. from E. Line

990 Ft. from W. Line

SECTION PLAT

CLAWSON POOL

Location

Rig up

Drilling and Remarks:

at 3292
5" casing 1/2
2000 acid
Sonicmeter Rtd
3000

RECORD

Cased in., ft.

Sand

Gas

Oil

Total Depth 3386

PRODUCTION

1st 24 hrs. Nat.

1st 24 hrs. after shot

Gas Cu. Ft.

Dry Hole

Abandoned

Date

SEP 11 1940 19

S. J. LEWIS Scout

Map No. _____ Sec. 18 Twp. 20 R. 11WWell No. 3 SchartzGulf

Company

Contractor

FIRST REPORT

C E L SW SW

Ft. from N. Line

660 Ft. from S. Line

Ft. from E. Line

990 Ft. from W. Line

SECTION PLAT

CLAWSON POOL

Location

Rig up

Drilling and Remarks:

Derrick

RECORD

Cased in., ft.

Sand

Gas

Oil

Total Depth

PRODUCTION

1st 24 hrs. Nat.

1st 24 hrs. after shot

Gas Cu. Ft.

Dry Hole

Abandoned

Date

JUL 24 1940 19

S. J. LEWIS Scout