



Section 18 Township 20 Range 11W
 Well No. #3 Schartz
 Company Hollow Drilling

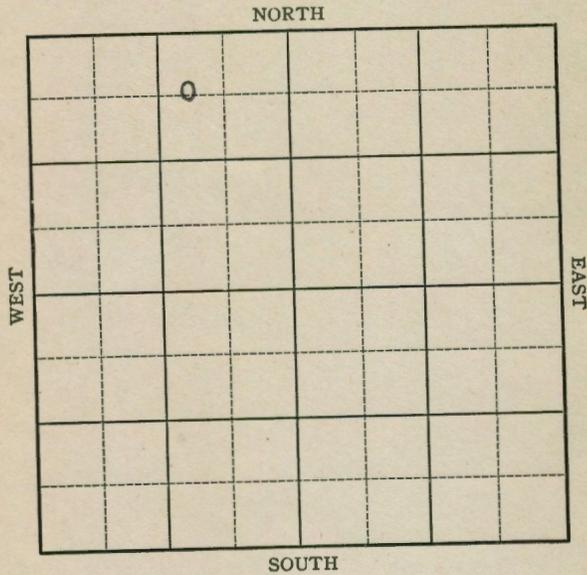

Sec. 18 Twp. 20 R. 11-W
 Well No. #3 Schartz Farr
Hollow Drilling Compan

(Silica)

660 Ft. from N. Line
 _____ Ft. from S. Line
990 Ft. from E. Line
 _____ Ft. from W. Line

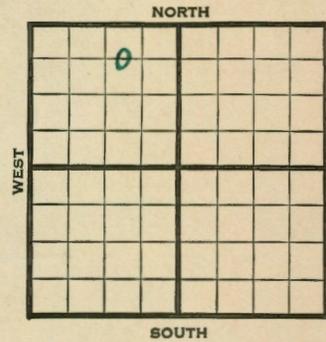

Elev. 1785

1941	REPORT
9/3	Rotary .
9/4	"
9/11	8" - 229' Drlg. 2010'
9/18	Anhy 530' Topeka 2655' Lans. 3069' Arb. 3310-13' T.I.
	5" - 3310½' RUST.
9/24	Arb. 3310' 5" - 3310½' T.D. 3318' Echometer potential 9254 bbls. Maximum 3000 bbls. 45. Gravity
	COMPLETED

Map No. 46 Sec. 18 Twp. 20 R. 11W

Well No. 3 Schartz

Hollow Drilling Company

COMPLETED Contractor

SECTION PLAT

C WL NE NW

660 Ft. from N. Line

_____ Ft. from S. Line

990 Ft. from E. Line

_____ Ft. from W. Line

	0		

SILICA POOL

Location _____

Rig up _____

Drilling and Remarks:

Core 3310
5" 3310 1/2
Echo Post 9254
Map 3000
45° 30'

RECORD

Cased _____ in., _____ ft.

Sand _____

Gas _____

Oil _____

Total Depth 3318

PRODUCTION

1st 24 hrs. Nat. _____

1st 24 hrs. after shot _____

Gas _____ Cu. Ft.

Dry Hole _____

Abandoned _____

Date

SEP 24 1941

S. J. LEWIS Scout

Map No. 46 Sec. 18 Twp. 20 R. 11W

Well No. 3 Schartz

Hollow Drilling Company

FIRST REPORT Contractor

SECTION PLAT

660 C W L NE NW

_____ Ft. from N. Line

_____ Ft. from S. Line

990 _____ Ft. from E. Line

_____ Ft. from W. Line

	0		

SILICA POOL

Location _____

Rig up _____

Drilling and Remarks:

Rotary

RECORD

Cased _____ in., _____ ft.

Sand _____

Gas _____

Oil _____

Total Depth _____

PRODUCTION

1st 24 hrs. Nat. _____

1st 24 hrs. after shot _____

Gas _____ Cu. Ft.

Dry Hole _____

Abandoned _____

Date

SEP 3 1941

S. J. LEWIS Scout