


Barton

Section 18 Township 20 Range 11-W  
 Well No. 4 Schartz  
 Company Gulf

NORTH Silica pool

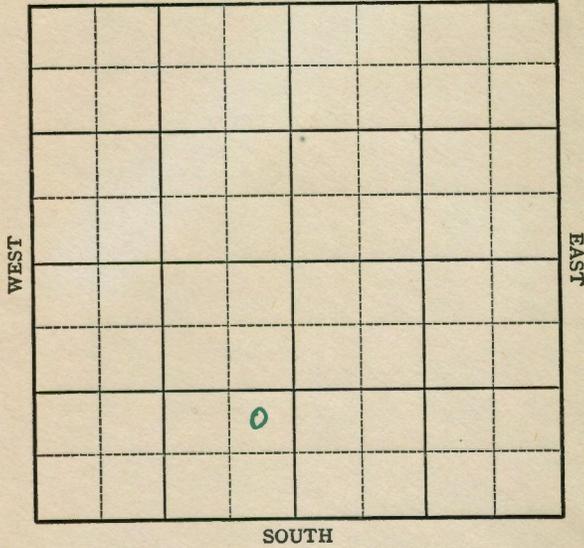


Barton

Sec. 18 Twp. 20 R. 11-W  
 Well No. #4 Schartz Farm \_\_\_\_\_  
Gulf Company \_\_\_\_\_

(Silica)

\_\_\_\_\_ Ft. from N. Line  
990 Ft. from S. Line  
330 Ft. from E. Line  
 \_\_\_\_\_ Ft. from W. Line

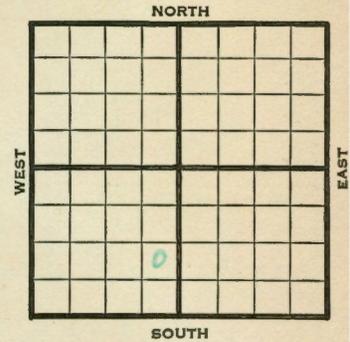

1941

REPORT

12/3

8-5/8" - 220'

Drlg. 1435'

12/11

3235 **Lans. 3078**

12/17

**Arb. 3359**

No shows

TD 3365

**ABANDONED**

Map No. 46 Sec. 18 Twp. 20 R. 11W

Well No. 4 Schartz

Gulf Company

ABANDONED Contractor

NE SE SW

SECTION PLAT


\_\_\_\_\_ Ft. from N. Line

990 Ft. from S. Line

330 Ft. from E. Line

\_\_\_\_\_ Ft. from W. Line

SILICA POOL

Location \_\_\_\_\_

Rig up \_\_\_\_\_

Drilling and Remarks:

Cr & 3359

Noshore

RECORD

Cased \_\_\_\_\_ in., \_\_\_\_\_ ft.

Sand \_\_\_\_\_

Gas \_\_\_\_\_

Oil \_\_\_\_\_

Total Depth 3965

PRODUCTION

1st 24 hrs. Nat. \_\_\_\_\_

1st 24 hrs. after shot \_\_\_\_\_

Gas \_\_\_\_\_ Cu. Ft.

Dry Hole \_\_\_\_\_

Abandoned \_\_\_\_\_

Date

DEC 17 1941 19

S. J. LEWIS Scout

Map No. 46 Sec. 18 Twp. 20 R. 11W

Well No. 4 Schartz

Gulf Company

FIRST REPORT Contractor

NE SE SW

SECTION PLAT


\_\_\_\_\_ Ft. from N. Line

990 Ft. from S. Line

330 Ft. from E. Line

\_\_\_\_\_ Ft. from W. Line

SILICA POOL

Location \_\_\_\_\_

Rig up \_\_\_\_\_

Drilling and Remarks:

8 5/8" - 220'

Drlg. 1435'

RECORD

Cased \_\_\_\_\_ in., \_\_\_\_\_ ft.

Sand \_\_\_\_\_

Gas \_\_\_\_\_

Oil \_\_\_\_\_

Total Depth \_\_\_\_\_

PRODUCTION

1st 24 hrs. Nat. \_\_\_\_\_

1st 24 hrs. after shot \_\_\_\_\_

Gas \_\_\_\_\_ Cu. Ft.

Dry Hole \_\_\_\_\_

Abandoned \_\_\_\_\_

Date

DEC 3 1941 19

S. J. LEWIS Scout