


Section 18 Township 20 Range 11W

Well No. #2 Schertz

Company M.B. Armer

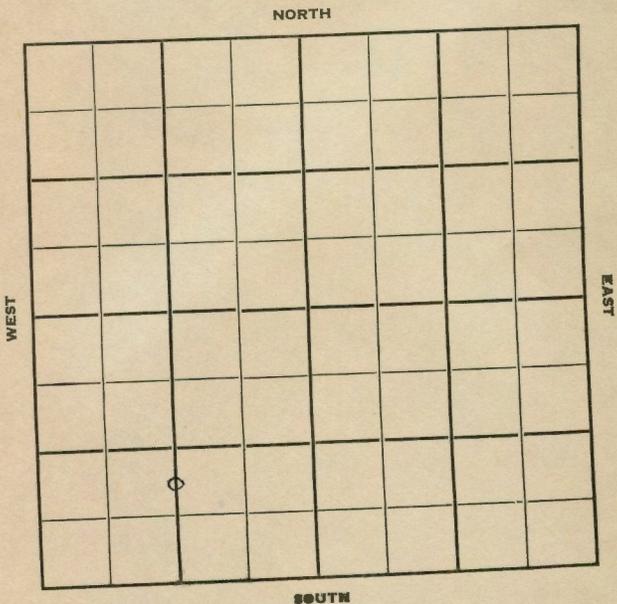

Sec. 18 Twp. 20 R. 11W

Well No. #2 Schertz Farm

M. B. Armer Company

Contractor

Silica Pool


990' Ft. from N. Line

Ft. from S. Line

Ft. from E. Line

1320' Ft. from W. Line

C S 1/2 N 1/2 SW

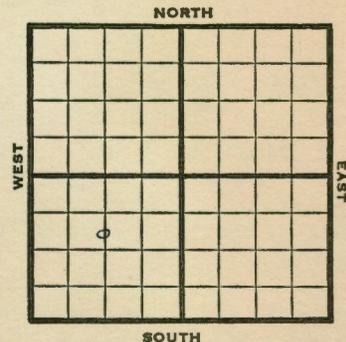

1950 Elev 1784 REPORT

2/22 Location

6/28 8" @ 310

Lans 3076

5 1/2" @ 3310

TD 3320

10/3316-18

1 goph

500 acid

20 boph

1500 acid

3 boph

Br lime 3093

Cong 3362

TD 3368

2500 acid

4 bwph

D&A

ABANDONED

Arb 3310-11

Lans (corr)3108

Map No. _____ Sec. 18 Twp. 20 R. 11W

Well No. 2 Schartz

M. B. Armer Company

Contractor

C S $\frac{1}{2}$ N $\frac{1}{2}$ SW


El. 1784
SECTION PLAT

990 Ft. from N. Line

_____ Ft. from S. Line

_____ Ft. from E. Line

1320 Ft. from W. Line

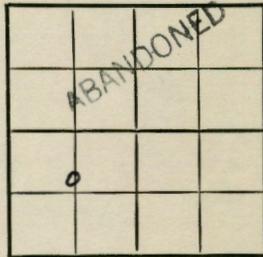

Barton County

Location _____

Rig up _____

Drilling and Remarks:

8" @ 310
Lans. 3076

Arb. 3310-11

5 $\frac{1}{2}$ " @ 3310

TD 3320

10/ 3316-18

1 goph

500 acid

Date JUN 28 1950

RECORD

Cased _____ in., _____ ft.

Sand _____

Gas _____

Oil _____

Total Depth 3368

PRODUCTION

1st 24 hrs. Nat. _____

1st 24 hrs. after shot _____

Gas _____ Cu. Ft.

Dry Hole _____

Abandoned _____

19 J. E. TYRA Scout

Map No. _____ Sec. 18 Twp. 20 R. 11W

Well No. 2 Schartz

M. B. Armer Company

Contractor

C S $\frac{1}{2}$ N $\frac{1}{2}$ SW


El. 1784
SECTION PLAT

990 Ft. from N. Line

_____ Ft. from S. Line

_____ Ft. from E. Line

1320 Ft. from W. Line

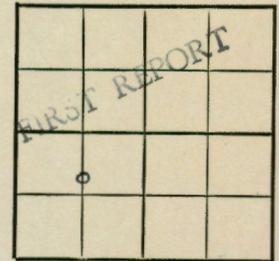

Barton County

Location _____

Rig up _____

Drilling and Remarks:

RECORD

Cased _____ in., _____ ft.

Sand _____

Gas _____

Oil _____

Total Depth _____

PRODUCTION

1st 24 hrs. Nat. _____

1st 24 hrs. after shot _____

Gas _____ Cu. Ft.

Dry Hole _____

Abandoned _____

Date

FEB 22 1950 19

J. E. TYRA Scout