


Section 18 Township 20 Range 11-W

Well No. #2 P. Schartz

Company Gulf

NORTH Silica Pool

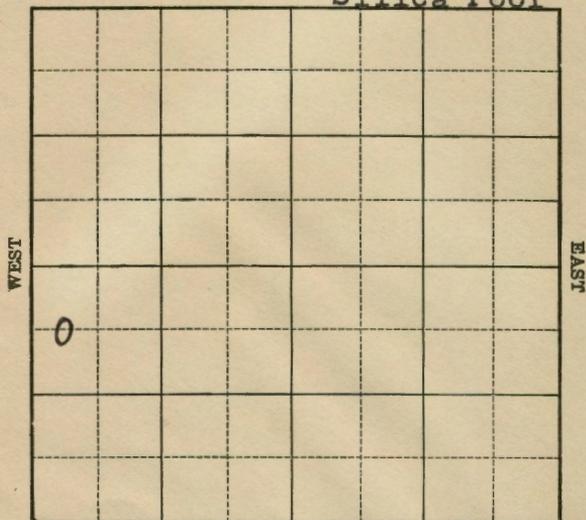

SOUTH

Sec. 18 Twp. 20 R. 11-W

Well No. #2 P. Schartz Farm

Gulf Company


(Silica)

660 Ft. from N. Line

Ft. from S. Line

Ft. from E. Line

330 Ft. from W. Line

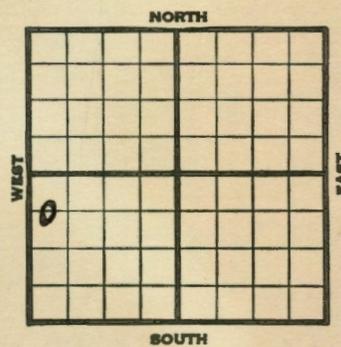

Elv. 1794

	REPORT
1939	
12/13	Drlg. 245' 8" - 242' WOC.
12/21	Drlg. 3298'
12/28	Arb. 3317' 5 1/2" - 3328'
	T.D. 3331' No shows.
1940	
1/4	T.D. 3341' 100' oil 2 1/2 hours.
1/11	" " " " " "
1/17	Arb. 3317'
	5" - 3328'
	T.D. 3383'
	SSO & W.
	ABANDONED

Map No. 46 Sec. 18 Twp. 20 R. 11W

Well No. 2 P. Schartz

Gulf Company

Contractor

ABANDONED

SECTION PLAT

660 C $W\frac{1}{2}$ NW SW

Ft. from N. Line

Ft. from S. Line

Ft. from E. Line

330 Ft. from W. Line

SILICA POOL

Location _____

RECORD

Cased _____ in., _____ ft.

Sand _____

Gas _____

Oil _____

Total Depth 338

PRODUCTION

1st 24 hrs. Nat. _____

1st 24 hrs. after shot _____

Gas _____ Cu. Ft.

Dry Hole _____

Abandoned _____

Rig up _____

Drilling and Remarks:

Q. & 3312

5" @ 3328

SSD & W.

Date

JAN 17 1940 19

Scout

Map No. 46 Sec. 18 Twp. 20 R. 11W

Well No. 2 P. Schartz

Gulf Company

Contractor

FIRST REPORT

SECTION PLAT

660 C $W\frac{1}{2}$ NW SW

Ft. from N. Line

Ft. from S. Line

Ft. from E. Line

330 Ft. from W. Line

SILICA POOL

Location _____

RECORD

Cased _____ in., _____ ft.

Sand _____

Gas _____

Oil _____

Total Depth _____

PRODUCTION

1st 24 hrs. Nat. _____

1st 24 hrs. after shot _____

Gas _____ Cu. Ft.

Dry Hole _____

Abandoned _____

Rig up _____

Drilling and Remarks:

Dr lg. 245

8" - 242

WOC

Date

DEC 13 1939 19

S. J. LEWIS Scout