


Barton

KANSAS

Section 18 Township 20 Range 11-W  
 Well No. #1 Peter Schartz  
 Company Gulf

NORTH

Marchand Pool

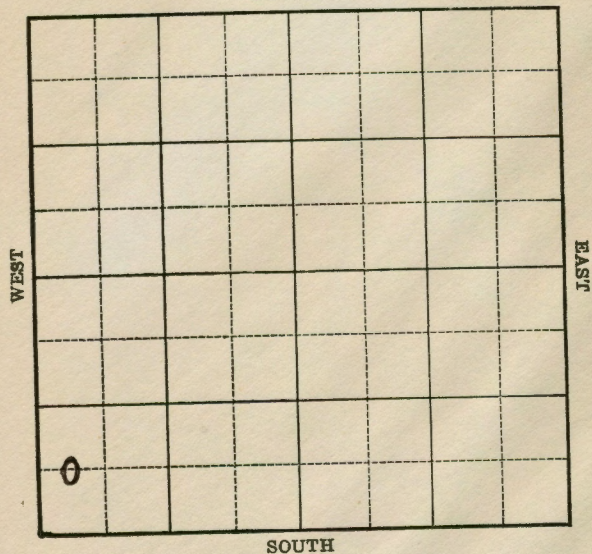


KANSAS

Barton

Sec. 18 Twp. 20 R. 11-W  
 Well No. #1 Peter Schartz Farm  
Gulf Company

(Marchand)

         Ft. from N. Line  
660 Ft. from S. Line  
         Ft. from E. Line  
330 Ft. from W. Line

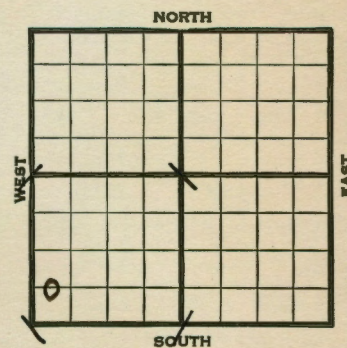

Elev. 1797

1939

REPORT

6/21

Rotary.

6/29

16" - 251' Drlg. 1985'

7/6

Topeka 2595' Ians. 3078'

Drlg. 3270'

7/13

Arb. 3296' 8" - 3297'

T.D. 3306' Swab 45 bbls. per  
 hour 4 hrs.

7/19

Arb. 3296'

8" - 3297'

T.D. 3306'

2000 acid.

Depthograph 3458 bbls.

Maximum 3000 bbls.

COMPLETED

Barton

KANSAS

Map No. 46 Sec. 18 Twp. 20 R. 11WWell No. 1 Peter Schartz

Gulf

Company

Contractor

COMPLETED

## SECTION PLAT

C W $\frac{1}{2}$  SW SW

Ft. from N. Line

660 Ft. from S. Line

Ft. from E. Line

330 Ft. from W. Line

MARCHAND POOL

|  |  |  |  |
|--|--|--|--|
|  |  |  |  |
|  |  |  |  |
|  |  |  |  |
|  |  |  |  |

Location

## RECORD

Cased \_\_\_\_\_ in., \_\_\_\_\_ ft.

Sand \_\_\_\_\_

Gas \_\_\_\_\_

Oil \_\_\_\_\_

Total Depth 3306

## PRODUCTION

1st 24 hrs. Nat. \_\_\_\_\_

1st 24 hrs. after shot \_\_\_\_\_

Gas \_\_\_\_\_ Cu. Ft.

Dry Hole \_\_\_\_\_

Abandoned \_\_\_\_\_

Date

JUL 19 1939 19

S. J. LEWIS

Scout

Barton

KANSAS

Map No. \_\_\_\_\_ Sec. 18 Twp. 20 R. 11WWell No. 1 Peter Schartz

Gulf

Company

Contractor

FIRST REPORT

## SECTION PLAT

C W $\frac{1}{2}$  SW SW

Ft. from N. Line

660 Ft. from S. Line

Ft. from E. Line

330 Ft. from W. Line

MARCHAND POOL

|  |  |  |  |
|--|--|--|--|
|  |  |  |  |
|  |  |  |  |
|  |  |  |  |
|  |  |  |  |

Location

## RECORD

Cased \_\_\_\_\_ in., \_\_\_\_\_ ft.

Sand \_\_\_\_\_

Gas \_\_\_\_\_

Oil \_\_\_\_\_

Total Depth \_\_\_\_\_

## PRODUCTION

1st 24 hrs. Nat. \_\_\_\_\_

1st 24 hrs. after shot \_\_\_\_\_

Gas \_\_\_\_\_ Cu. Ft.

Dry Hole \_\_\_\_\_

Abandoned \_\_\_\_\_

Date

JUN 21 1939 19

S. J. LEWIS

Scout