

KANSAS

Barton

Barton

Sec. 18 Twp. 20 R. 11-WWell No. #1 Scheufler FarmCompany C. E. Ash et al

(Silica pool)


660 Ft. from N. Line

Ft. from S. Line

Ft. from E. Line


990 Ft. from W. Line

Elev. 1785

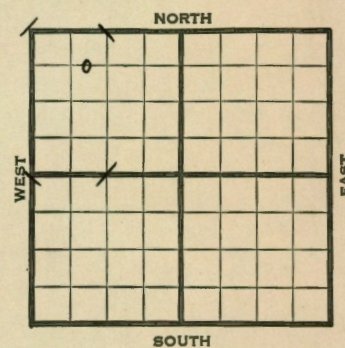Section 18 Township 20 Range 11-WWell No. #1 ScheuflerCompany C. E. Ash et al

(Silica)

NORTH

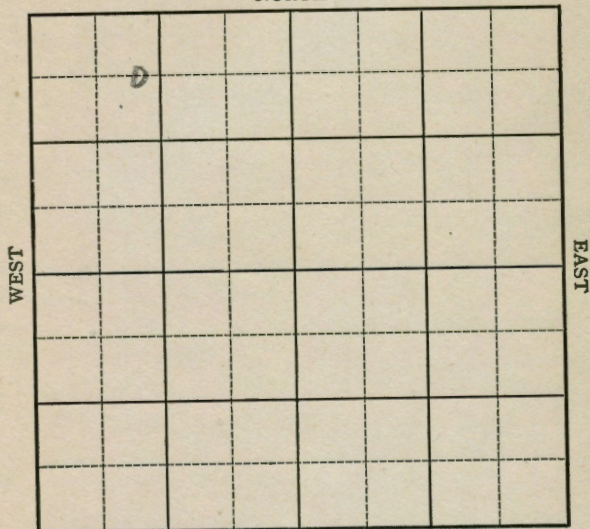

SOUTH

1941	REPORT
8/6	Location
8/15	8" 314 WOC
8/21	Anhy 530' Drlg. 2582'
8/28	Lans. 3069' Arb. 3313-16' T.D. 5" - 3314' RUST.
9/4	T.D. 3325' H.F.O.
9/10	Arb. 3313' 5" - 3314' T.D. 3325'
	Depthograph potential 3258 bbls. Maximum 3000 bbls.
	45. Gravity
	COMPLETED

Map No. _____ Sec. 18 Twp. 20 R. 11WWell No. 1 Scheufler
C. E. Ash etal Company

Contractor

FIRST REPORT

C E L NW NW


660 Ft. from N. Line

_____ Ft. from S. Line

_____ Ft. from E. Line

990 Ft. from W. Line

SECTION PLAT

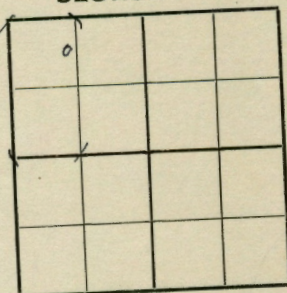

SILICA POOL

Location X

Rig up _____

Drilling and Remarks:

RECORD

Cased _____ in., _____ ft.

Sand _____

Gas _____

Oil _____

Total Depth _____

PRODUCTION

1st 24 hrs. Nat. _____

1st 24 hrs. after shot _____

Gas _____ Cu. Ft.

Dry Hole _____

Abandoned _____

Date

AUG 6 1941

19

S. J. LEWIS

Scout

Map No. _____ Sec. 18 Twp. 20 R. 11WWell No. 1 Scheufler

C. E. Ash etal Company

COMPLETED

Contractor

C E L NW NW

660 Ft. from N. Line


_____ Ft. from S. Line

_____ Ft. from E. Line

990 Ft. from W. Line

SILICA POOL

SECTION PLAT

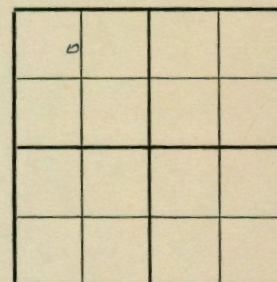

Location _____

Rig up _____

Drilling and Remarks:

Dr 83135" @ 3314Dep. 11 P. 83258Max 800045° Gr

RECORD

Cased _____ in., _____ ft.

Sand _____

Gas _____

Oil _____

Total Depth 3320

PRODUCTION

1st 24 hrs. Nat. _____

1st 24 hrs. after shot _____

Gas _____ Cu. Ft.

Dry Hole _____

Abandoned _____

Date

SEP 10 1941 19S. J. LEWIS Scout