

KANSAS

Barton


FORM 51 5M 10-41 PETROL

Section 8 Township 20 Range 11-W

Well No. #2 Duncan "A"

Company Simpson Oil et al

NORTH Silica Pool

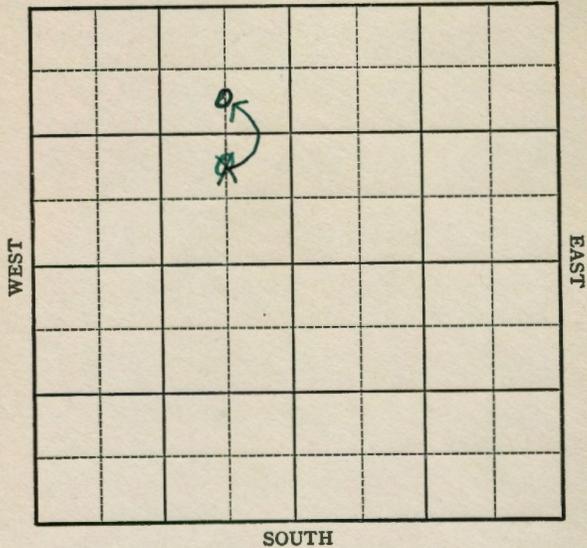

FORM 252-A
5M 10-41 PETROL

KANSAS

Barton

Sec. 8 Twp. 20 R. 11-W

Well No. #2 Duncan "A" Farm _____

Simpson Oil et al Company _____


(Silica)

990 Ft. from N. Line

~~990~~ Ft. from S. Line

660 Ft. from E. Line

_____ Ft. from W. Line

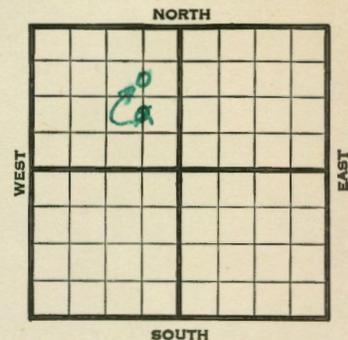

1941

REPORT

12/23 Location

12/31 Rotary.

1942

1/8 10" - 275' Drlg. 755'

1/15 Anhy 475' Drlg. 2800'

1/21 Arb. 3387'

T.D. 3398'

No shows.

ABANDONED

Map No. 46 Sec. 8 Twp. 20 R. 11W

Well No. 2 Duncan "A"

Simpson Oil et al. Company

CORRECTION Contractor

C SL NE NW


990 Ft. from N. Line

Ft. from S. Line

660 Ft. from E. Line

Ft. from W. Line

SECTION PLAT

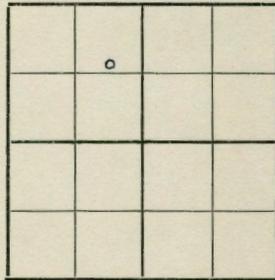

SILICA POOL

Location _____

Rig up _____

Drilling and Remarks:

Reported
C NL SE NW

RECORD

Cased _____ in., _____ ft.

Sand _____

Gas _____

Oil _____

Total Depth _____

PRODUCTION

1st 24 hrs. Nat. _____

1st 24 hrs. after shot _____

Gas _____ Cu. Ft.

Dry Hole _____

Abandoned _____

Date

JAN 14 1942 19

S. J. LEWIS Scout

Map No. 46 Sec. 8 Twp. 20 R. 11W

Well No. 2 Duncan "A"

Simpson Oil et al. Company

FIRST REPORT Contractor

C NL SE NW


Ft. from N. Line

990 Ft. from S. Line

660 Ft. from E. Line

Ft. from W. Line

SECTION PLAT

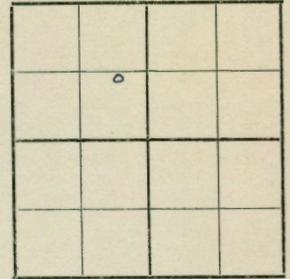

SILICA POOL

Location XX

Rig up _____

Drilling and Remarks:

RECORD

Cased _____ in., _____ ft.

Sand _____

Gas _____

Oil _____

Total Depth _____

PRODUCTION

1st 24 hrs. Nat. _____

1st 24 hrs. after shot _____

Gas _____ Cu. Ft.

Dry Hole _____

Abandoned _____

Date

DEC 23 1941 19

S. J. LEWIS Scout

Barton

KANSAS

Map No. 46 Sec. 8 Twp. 20 R. 11W

Well No. 2 Duncan "A"

Simpson Oil et al. Company

ABANDONED Contractor

C SL NE NW

990 Ft. from N. Line

_____ Ft. from S. Line

660 Ft. from E. Line

_____ Ft. from W. Line

SECTION PLAT

SILICA POOL

Location _____

Rig up _____

Drilling and Remarks:

*Ar 43387
No shows*

RECORD

Cased _____ in., _____ ft.

Sand _____

Gas _____

Oil _____

Total Depth 3398

PRODUCTION

1st 24 hrs. Nat. _____

1st 24 hrs. after shot _____

Gas _____ Cu. Ft.

Dry Hole _____

Abandoned _____

Date

JAN 21 1942 19

S. J. LEWIS Scout