


Section 8 Township 20 Range 11-W

Well No. #1 Duncan "B"

Company Simpson Oil & Alpine

NORTH Ellinwood Pool

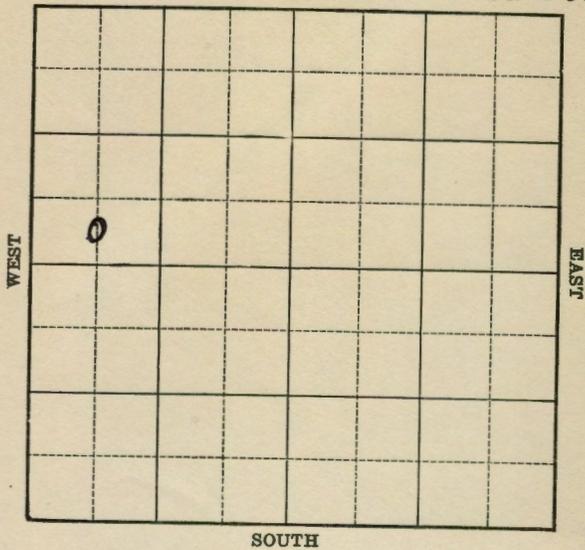

Sec. 8 Twp. 20 R. 11-W

Well No. #1 Duncan "B" Farm

Simpson Oil & Alpine Company  
(Ellinwood)


         Ft. from N. Line

330 Ft. from S. Line

         Ft. from E. Line

660 Ft. from W. Line

**Elev. 1781**

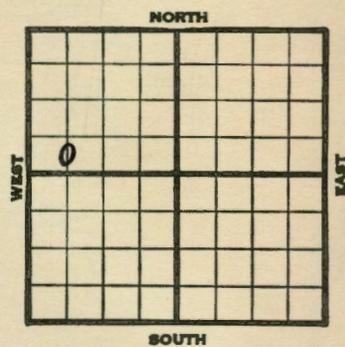

1940	REPORT
2/28	Location
3/8	B.R.R.
3/14	10" - 205' WOC.
3/21	Anhy 540' Topeka 2665' Lans. 3060' Arb. 3304-08' T.D. 5" - 3304' RUST.
3/28	T.D. 3314' 1500' oil 14 hours.
4/4	T.D. 3317' 5250 acid. Testing.
4/10	Arb. 3304' T.D. 3317' 750 acid. 1500 acid. 3000 acid. Depthograph potential 2047 bbls.
	<b>COMPLETED</b>


Form 26—200 Bks.—1-40—Palace **Barton KANSAS**  
 Map No. 46 Sec. 8 Twp. 20 R. 11W  
 Well No. 1 Duncan "B"  
Simpson Oil & Alpine Company  
 Contractor

**COMPLETED**

C S  $\frac{1}{2}$  SW NW

\_\_\_\_\_ Ft. from N. Line  
330 Ft. from S. Line  
 \_\_\_\_\_ Ft. from E. Line  
660 Ft. from W. Line

**SECTION PLAT**

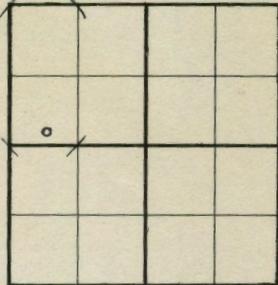

**ELLINWOOD POOL**

Location \_\_\_\_\_

Rig up \_\_\_\_\_

Drilling and Remarks:

750 acid  
1500 acid  
3000 acid

Depth. post.

2047 bbls

**RECORD**

Cased \_\_\_\_\_ in., \_\_\_\_\_ ft.  
 Sand burble 3304  
 Gas \_\_\_\_\_  
 Oil \_\_\_\_\_  
 Total Depth 3317

**PRDUCTION**

1st 24 hrs. Nat. \_\_\_\_\_  
 1st 24 hrs. after shot \_\_\_\_\_  
 Gas \_\_\_\_\_ Cu. Ft.  
 Dry Hole \_\_\_\_\_  
 Abandoned \_\_\_\_\_

Date

APR 10 1940 19

S. J. LEWIS Scout


Form 26—1M Bks.—2-29 **Barton KANSAS**  
 Map No. 46 Sec. 8 Twp. 20 R. 11W  
 Well No. 1 Duncan "B"  
Simpson Oil & Alpine Company  
 Contractor

**FIRST REPORT**

**SECTION PLAT**

C S  $\frac{1}{2}$  SW NW

\_\_\_\_\_ Ft. from N. Line  
330 Ft. from S. Line  
 \_\_\_\_\_ Ft. from E. Line  
660 Ft. from W. Line

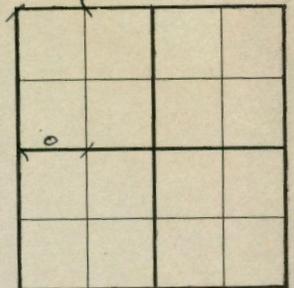

**ELLINWOOD POOL**

Location X

Rig up \_\_\_\_\_  
 Drilling and Remarks:

**RECORD**

Cased \_\_\_\_\_ in., \_\_\_\_\_ ft.  
 Sand \_\_\_\_\_  
 Gas \_\_\_\_\_  
 Oil \_\_\_\_\_  
 Total Depth \_\_\_\_\_

**PRODUCTION**

1st 24 hrs. Nat. \_\_\_\_\_  
 1st 24 hrs. after shot \_\_\_\_\_  
 Gas \_\_\_\_\_ Cu. Ft.  
 Dry Hole \_\_\_\_\_  
 Abandoned \_\_\_\_\_

Date

FEB 28 1940 19

S. J. LEWIS Scout