

KANSAS


Form 51-5M-7-39-Palace

Barton

Section 8 Township 20 Range 11-W

Well No. #1 Herter

Company Bodine Drilling et al

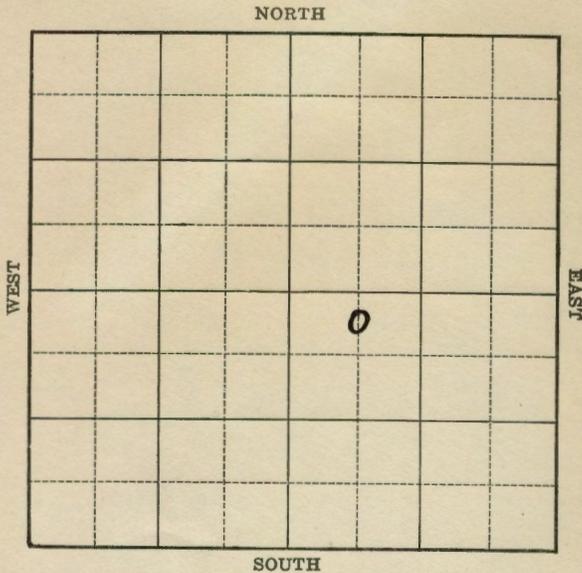

FORM 252-A 5M **KANSAS**

Barton

Sec. 8 Twp. 20 R. 11-W

Well No. #1 Herter Farm

Bodine Drilling et al Company


(Ellinwood)

330 Ft. from N. Line

Ft. from S. Line

Ft. from E. Line

660 Ft. from W. Line

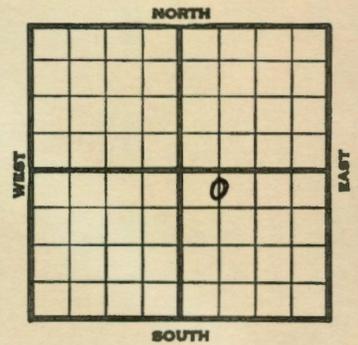

Elev. 1780

1940	REPORT
1/24	Rotary.
2/1	10" - 200' T.D. 221' WOC.
2/8	Drlg. 2550'
2/15	Arb. 3310' 5" - 3310'
	Sat. 3316' T.D. 3320' RUST.
2/23	" " " " "
2/29	T.D. 3321' 2500 acid.
	Testing.
3/6	Arb. 3310'
	T.D. 3321'
	5" - 3310'
	500 acid.
	2000 acid.
	Potential 164 bbls. on pump.
	COMPLETED

Map No. 46 Sec. 8 Twp. 20 R. 11W

Well No. 1 Herter

Bodine Drlg. etal Company

Contractor

COMPLETED

C N L NW SE

330 Ft. from N. Line

_____ Ft. from S. Line

_____ Ft. from E. Line

660 Ft. from W. Line

ELLINWOOD POOL

SECTION PLAT

		o	

Location _____

Rig up _____

Drilling and Remarks:

500 acid
2000 acid
5" C 3310
potential
16.4 bbls
pump

RECORD

Cased _____ in., _____ ft.

Sand Arbuckle 3310

Gas _____

Oil _____

Total Depth 3321

PRODUCTION

1st 24 hrs. Nat. _____

1st 24 hrs. after shot _____

Gas _____ Cu. Ft.

Dry Hole _____

Abandoned _____

Date

MAR 6 1940 S. J. LEWIS Scout

Map No. 49 Sec. 8 Twp. 20 R. 11W

Well No. 1 Herter

Bedine Drilling etal Company

Contractor

SECTION PLAT

C N L NW SE

330 Ft. from N. Line

_____ Ft. from S. Line

_____ Ft. from E. Line

660 Ft. from W. Line

ELLINWOOD POOL

		o	

Location _____

Rig up _____

Drilling and Remarks:

Rotary

RECORD

Cased _____ in., _____ ft.

Sand _____

Gas _____

Oil _____

Total Depth _____

PRODUCTION

1st 24 hrs. Nat. _____

1st 24 hrs. after shot _____

Gas _____ Cu. Ft.

Dry Hole _____

Abandoned _____

Date

JAN 24 1940 S. J. LEWIS Scout