

KANSAS

Barton


Form 51-5M-7-39-Palace

Section 8 Township 20 Range 11-W

Well No. #2 Howard

Company Gulf

NORTH Ellinwood Pool

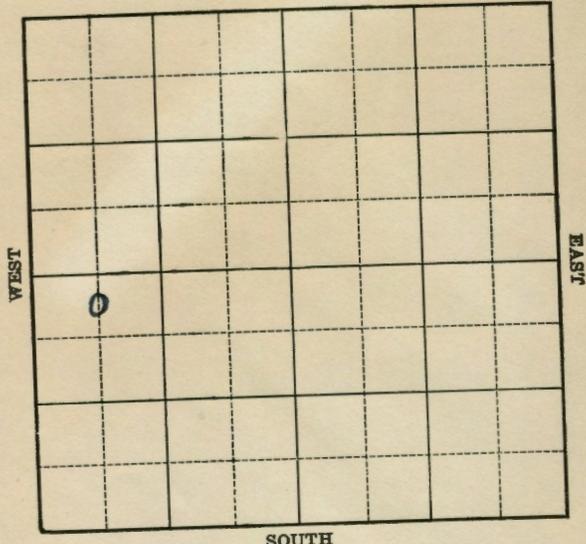

FORM 252-A 5M KANSAS

Barton

Sec. 8 Twp. 20 R. 11-W

Well No. #2 Howard Farm

Gulf Company


(Ellinwood)

330 Ft. from N. Line

Ft. from S. Line

Ft. from E. Line

660 Ft. from W. Line

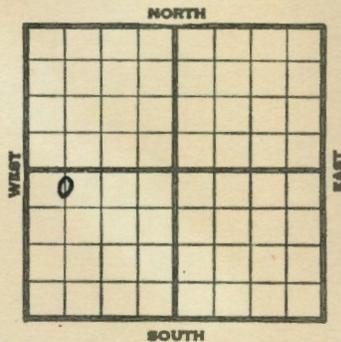

Elev. 1779

1940	REPORT
2/14	Derrick.
2/23	8" - 235' Drlg. 1747'
2/29	Arb. 3290' T.D. 3294'
	5" - 3290' RUST.
3/8	T.D. 3306' 500' oil. Tubing.
3/13	Arb. 3290'
	5" - 3290'
	T.D. 3306'
	Depthograph potential 8303 bbls.
	Maximum 3000 bbls.
	<b>COMPLETED</b>

Map No. 46 Sec. 8 Twp. 20 R. 11W

Well No. 2 Howard

Gulf Company

Contractor

**COMPLETED**

**SECTION PLAT**

C  $N\frac{1}{2}$  NW SW

330 Ft. from N. Line

\_\_\_\_\_ Ft. from S. Line

\_\_\_\_\_ Ft. from E. Line

660 Ft. from W. Line


**ELLINWOOD POOL**

Location \_\_\_\_\_

**RECORD**

Cased \_\_\_\_\_ in., \_\_\_\_\_ ft.

Sand \_\_\_\_\_

Gas \_\_\_\_\_

Oil \_\_\_\_\_

Total Depth 3306

**PRODUCTION**

1st 24 hrs. Nat. \_\_\_\_\_

1st 24 hrs. after shot \_\_\_\_\_

Gas \_\_\_\_\_ Cu. Ft.

Dry Hole \_\_\_\_\_

Abandoned \_\_\_\_\_

Rig up \_\_\_\_\_

Drilling and Remarks:

*cu x 3290*

*5" @ 3290*

*Depth graphed out.  
8303*

*Maximum 3000*

Date

MAR 13 1940 19

S. J. LEWIS Scout

Map No. 46 Sec. 8 Twp. 20 R. 11W

Well No. 2 Howard

Gulf Company

Contractor

**FIRST REPORT**

**SECTION PLAT**

C  $N\frac{1}{2}$  NW SW

330 Ft. from N. Line

\_\_\_\_\_ Ft. from S. Line

\_\_\_\_\_ Ft. from E. Line

660 Ft. from W. Line


**ELLINWOOD POOL**

Location \_\_\_\_\_

**RECORD**

Cased \_\_\_\_\_ in., \_\_\_\_\_ ft.

Sand \_\_\_\_\_

Gas \_\_\_\_\_

Oil \_\_\_\_\_

Total Depth \_\_\_\_\_

**PRODUCTION**

1st 24 hrs. Nat. \_\_\_\_\_

1st 24 hrs. after shot \_\_\_\_\_

Gas \_\_\_\_\_ Cu. Ft.

Dry Hole \_\_\_\_\_

Abandoned \_\_\_\_\_

Rig up \_\_\_\_\_

Drilling and Remarks:

**Derrick**

Date

FEB 14 1940 19

S. J. LEWIS Scout