


KANSAS

Form 51-5M-7-40-Palace

Barton

Section 8 Township 20 Range 11-WWell No. #5 HowardCompany Gulf

NORTH Silica Pool

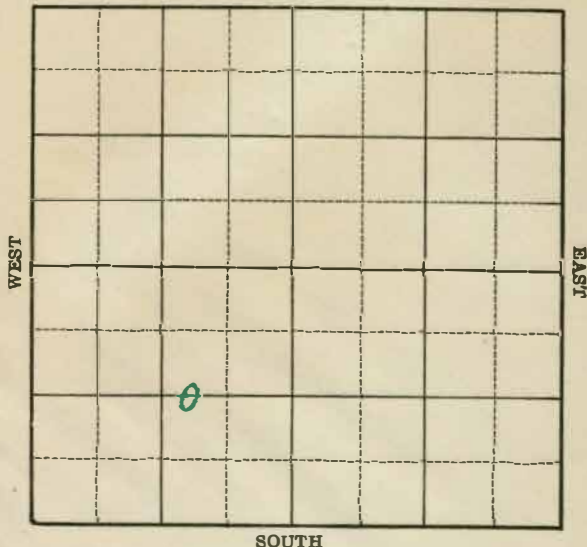

FORM 252-A 5M 7-40 PETROL

KANSAS

Barton

Sec. 8 Twp. 20 R. 11-WWell No. #5 Howard FarmGulf


Company

(Silica)

Ft. from N. Line

1320 Ft. from S. Line990 Ft. from E. Line

Ft. from W. Line

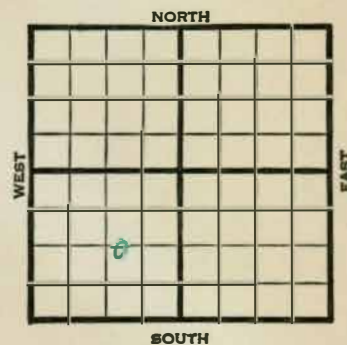

Elev. 1778

1940	REPORT
9/18	Rotary
9/26	8" - 243' Drlg. 2680'
10/3	Arb. 3294½-96' T.D. 5" - 3295'
	RUST.
10/10	3305' - 1000' oil 6 hours.
	3308' - 1400' oil at 3318'
	Swab 48 bbls. 1 hour, 2000 acid.
	Pump 114 bbls. fluid at 3326'
	3000' oil.
10/16	Arb. 3294½'
	5" - 3295'
	T.D. 3326'
	5000 acid.
	Pump 624 oil & 54 water.
	COMPLETED

Map No. 46 Sec. 8 Twp. 20 R. 11WWell No. 5 HowardGulf

Company

Contractor

COMPLETED

C W L E $\frac{1}{2}$ SW

SECTION PLAT

Ft. from N. Line

1320 Ft. from S. Line990 Ft. from E. Line

Ft. from W. Line

SILICA POOL

Location

RECORD

Cased in., ft.Sand Gas Oil Total Depth 3226

PRODUCTION

1st 24 hrs. Nat. 1st 24 hrs. after shot Gas Cu. Ft.Dry Hole Abandoned

Date

OCT 16 1940 19S. J. LEWIS

Scout

Map No. 46 Sec. 8 Twp. 20 R. 11WWell No. 5 HowardGulf

Company

Contractor

FIRST REPORT

C W L E $\frac{1}{2}$ SW

SECTION PLAT

Ft. from N. Line

1320 Ft. from S. Line990 Ft. from E. Line

Ft. from W. Line

SILICA POOL

Location

RECORD

Cased in., ft.Sand Gas Oil Total Depth

PRODUCTION

1st 24 hrs. Nat. 1st 24 hrs. after shot Gas Cu. Ft.Dry Hole Abandoned

Date

SEP 18 1940 19S. J. LEWIS

Scout