


KANSAS

Barton

Form 51-5M-7-40-Palace

Section 8 Township 20 Range 11-W
 Well No. #4 Bertha Howard
 Company Gulf

NORTH Ellinwood Pool

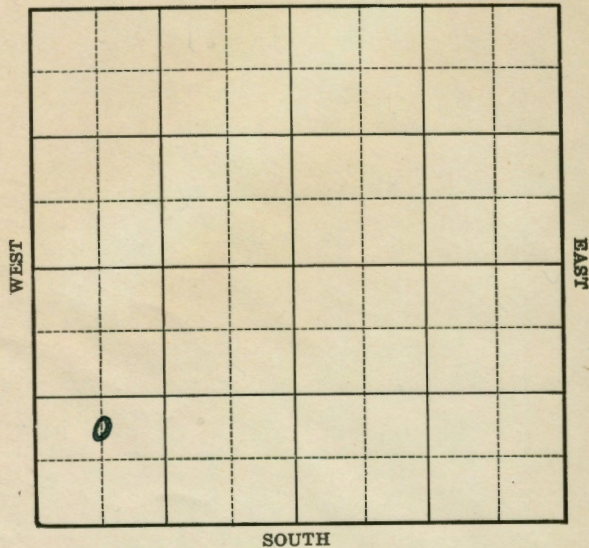


FORM 252-A 5M 2-40

Barton

Sec. 8 Twp. 20 R. 11-W
 Well No. #4 Bertha Howard Farm
Gulf Company
 (Ellinwood)

Ft. from N. Line
990 Ft. from S. Line
 Ft. from E. Line
660 Ft. from W. Line

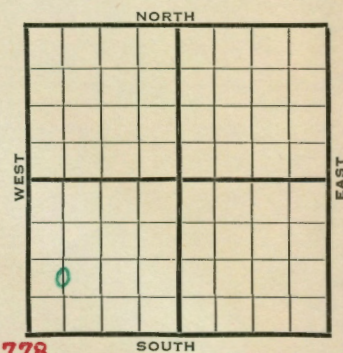

Elev. 1778

1940

REPORT

7/31 Bldg. rotary derrick.
 8/8 8" - 226' Drlg. 2000'
 8/14 **ArB. 3289-90** T.D. 5½" 3290'
 RUST.
 8/22 T.D. 3310' 3000' oil.
 Swab 14 bbls. per hr. 2 hrs.
 2000 acid.
 8/28 **Arb. 3289**
 5" 3290
 TD 3310
 2000 acid
 Sonimeter Pot. 2870

COMPLETED

Map No. Sec. 8 Twp. 20 R. 11WWell No. 4 Bertha HowardGulf

Company

Contractor

COMPLETEDC N $\frac{1}{2}$ SW SW

Ft. from N. Line

990 Ft. from S. Line

Ft. from E. Line

660 Ft. from W. Line

ELLINWOOD POOL

SECTION PLAT

0			

Location

RECORD

Cased in., ft.

Rig up

Sand

Drilling and Remarks:

Gas

Oil

Total Depth 3310**PRODUCTION**

1st 24 hrs. Nat.

1st 24 hrs. after shot

Gas Cu. Ft.

Dry Hole

Abandoned

Date

AUG 28 1940 19S. J. LEWIS ScoutMap No. 46 Sec. 8 Twp. 20 R. 11WWell No. 4 Bertha HowardGulf

Company

Contractor

FIRST REPORTC N $\frac{1}{2}$ SW SW

Ft. from N. Line

990 Ft. from S. Line

Ft. from E. Line

660 Ft. from W. Line

ELLINWOOD POOL

SECTION PLAT

0			

Location

RECORD

Cased in., ft.

Rig up

Sand

Drilling and Remarks:

Gas

Bldg. Roty Derrick

Total Depth

PRODUCTION

1st 24 hrs. Nat.

1st 24 hrs. after shot

Gas Cu. Ft.

Dry Hole

Abandoned

Date

JUL 31 1940 19S. J. LEWIS Scout