

Section 11 Township 20 Range 3W

Well No. #1 Kreibiel

Company Texas Pacific Oil & Gas

Wildcat

NORTH

WEST

EAST

SOUTH

0

McPherson

KANSAS

Sec. 11 Twp. 20 R. 3W

Well No. #1 Krebiel Farm

Texas Pacific Oil & Gas

Wildcat (Mallard Drlg., Contr.) Company

_____ Ft. from N. Line

330'


_____ Ft. from S. Line

_____ Ft. from E. Line

990'

_____ Ft. from W. Line

SE SW SE

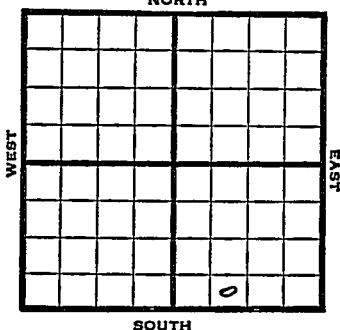

1949

Elev 1497' REPORT

12/14

RUR

12/21

10" @ 208'

Drlg 2391'

12/28

Lansing 2370'

Drlg 2741'

1950

3/29

TD 3056'

10" @ 208'

5" @ 3015'

Lans 2370'

Miss 3014'

Perf 3045-53

20 BOPD

Comp

COMPLETED

Kansas

Map No. _____ Sec. 11 Twp. 20 R. 3WWell No. 1 Krebiel

Texas Pacific Oil & Gas Company

Mallard Drlg. Contractor


SE SW SE

FIRST REPORT
SECTION PLAT

_____ Ft. from N. Line

_____ 330 Ft. from S. Line

_____ Ft. from E. Line

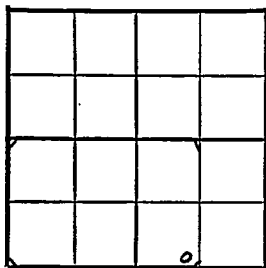_____ 990 Ft. from W. Line

McPherson County

Location _____

Rig up _____

Drilling and Remarks:

R U R

RECORD

Cased _____ in., _____ ft.

Sand _____

Gas _____

Oil _____

Total Depth _____

PRODUCTION

1st 24 hrs. Nat. _____

1st 24 hrs. after shot _____

Gas _____ Cu. Ft.

Dry Hole _____

Abandoned _____

Date

DEC 14 1949

19

S. J. LEWIS

Scout

Kansas

Map No. _____ Sec. 11 Twp. 20 R. 3W

Well No. 1 Krebiel

Texas Pacific Oil & Gas Company

Contractor

SE SW SE

E1.1497
SECTION PLAT

_____ Ft. from N. Line

330 Ft. from S. Line

_____ Ft. from E. Line

990 Ft. from W. Line

COMPLETE			
			G

McPherson County

Location _____

Rig up _____

Drilling and Remarks:

*10" @ 208
5" @ 3015
Loss 2370
miss 3014
Prof 3045-53
20 BOPD*

RECORD

Cased _____ in., _____ ft.

Sand _____

Gas _____

Oil _____

Total Depth 3056

PRODUCTION

1st 24 hrs. Nat. _____

1st 24 hrs. after shot _____

Gas _____ Cu. Ft.

Dry Hole _____

Abandoned _____

Date

MAR 29 1950

19

J. E. TYRA Scout