


Section 11 Township 20 Range 8-W

Well No. #1 ~~Maughlin~~ Ginther

Company Mitchell Drilling

Chase Pool

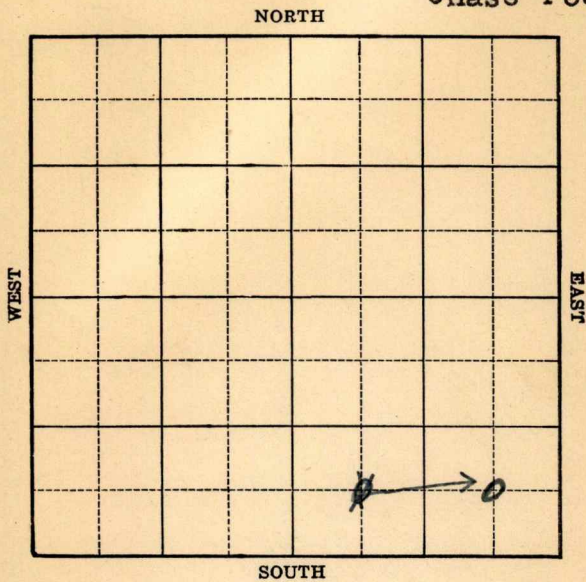


KANSAS

Rice

Sec. 11 Twp. 20 R. 8-WWell No. #1 Maughlin Ginther FarmMitchell Drilling Company

(Chase)

Ft. from N. Line

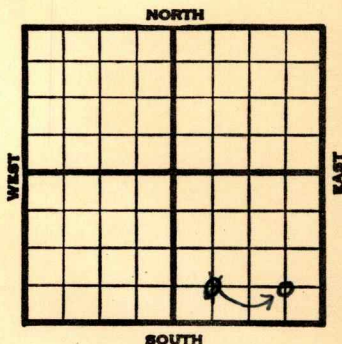660 Ft. from S. Line660 Ft. from E. Line660 Ft. from W. Line

Elev. 1655

1940	REPORT
3/13	Rotary.
3/21	8" - 155' WOC.
3/28	Drlg. 3060'
4/4	Cong. 3184' Viola 3248'
	Simp. 3297' T.D. 3300'
	5" - 3295' RUST.
4/12	" " "
4/18	" " "
4/25	" " "
5/2	" " "
5/8	Simp. Sd. 3297'
	5" @ 3295'
	Total depth 3312'
	500 gals acid
	water.
	ABANDONED

Map No. 49 Sec. 11 Twp. 20 R. 8WWell No. 1 MaughlinMitchell Drilling Company

Contractor

FIRST REPORT

C SW SE

Ft. from N. Line

660 Ft. from S. Line

Ft. from E. Line

660 Ft. from W. Line

CHASE POOL

SECTION PLAT

		o	

Location _____

Rig up _____

Drilling and Remarks:

Rotary

RECORD

Cased _____ in., _____ ft.

Sand _____

Gas _____

Oil _____

Total Depth _____

PRODUCTION

1st 24 hrs. Nat. _____

1st 24 hrs. after shot _____

Gas _____ Cu. Ft.

Dry Hole _____

Abandoned _____

Date

MAR 13 1940

19

S. J. LEWIS

Scout

~~Barton~~ RiceMap No. 49 Sec. 11 Twp. 20 R. 8WWell No. 1 GintherMitchell Drilling Company

CORRECTION

Contractor

SECTION PLAT

C SE SE

Ft. from N. Line

660 Ft. from S. Line660 Ft. from E. Line

Ft. from W. Line

			o

CHASE POOL

Location _____

Rig up _____

Drilling and Remarks:

Reported as

#1 Maughlin

and C SW SE

RECORD

Cased _____ in., _____ ft.

Sand _____

Gas _____

Oil _____

Total Depth _____

PRODUCTION

1st 24 hrs. Nat. _____

1st 24 hrs. after shot _____

Gas _____ Cu. Ft.

Dry Hole _____

Abandoned _____

Date

MAR 20 1940

19

S. J. LEWIS

Scout

Map No. 49 Sec. 11 Twp. 20 R. 8WWell No. 1 GintherMitchell Drilling

Company

Contractor

ABANDONED

C SE SE

Ft. from N. Line

660 Ft. from S. Line660 Ft. from E. Line

Ft. from W. Line

SECTION PLAT

			6

CHASE POOL

Location _____

Rig up _____

Drilling and Remarks:

*Simp Sol 3297**5" C 3295**500 aciol**Water.*

RECORD

Cased _____ in., _____ ft.

Sand _____

Gas _____

Oil _____

Total Depth 33 1/2

PRODUCTION

1st 24 hrs. Nat. _____

1st 24 hrs. after shot _____

Gas _____ Cu. Ft.

Dry Hole _____

Abandoned _____

Date

MAY 8 1940 19S. J. LEWIS Scout