


Section 11 Township 20 Range 8 W

Well No. # 1 Sangster

Company Drillers Prod. & Tom Allan

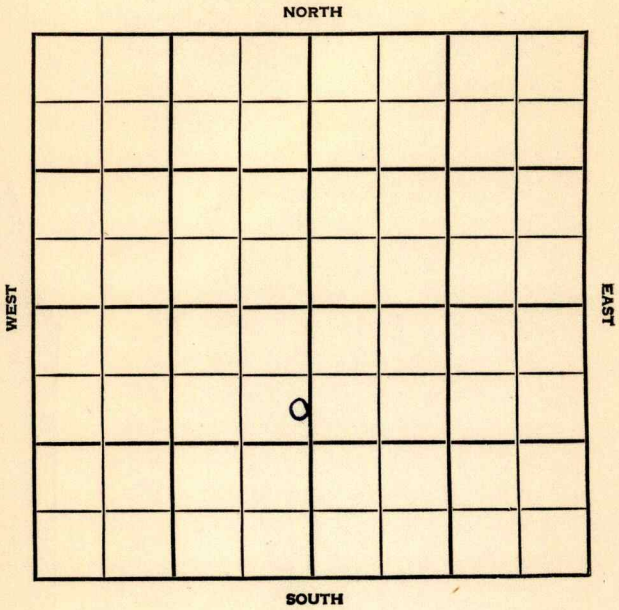

Rice KANSAS


| | | |
|------|------|----|
| SEC. | TWP. | R. |
| 11 | 20 | 8W |

WELL NO. 1 Sangster FARM

COMPANY Drillers Prod. & Tom Allan

CONTRACTOR Tom Allan
Lyons Pool

990 Ft. from N. Line
 _____ Ft. from S. Line
 50 Ft. from E. Line
 _____ Ft. from W. Line

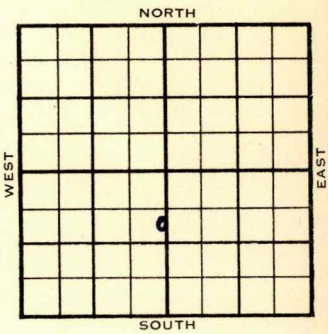

SE NE SW

| | | |
|------|---------------------------|--------|
| 1954 | ELEVATION 1659' | REPORT |
|------|---------------------------|--------|

10/20 Location

11/23 Spud 10-23-54
 SI Gas Well.
 TD 3198'
 8-5/8" @ 170'
 Br. Lime 2770' Lans 2805' Cong 3148'
 Simp 3159' Arb. 3193'
 TD 3197'
 5" @ 3195'
 DD 3198' 500 A Comp SI Gas Well
 3,300,000 cfcpd.

COMPLETED

